

MISSISSIPPI DEPARTMENT OF NATURAL RESOURCES

Bureau of Land and Water Resources

Southport Mall

P.O. Box 10631

Jackson, Mississippi 39209

WATER WELL DRILLERS LOG

Griner Drilling Service, Inc.

Smith

INDEXED

SMITH
Q 34
2-26-81
2-26-81

date well completed

firm name

county well located

LANDOWNER:

description of formations encountered

from

to

Tatnam Oil & Gas
Suite 3300
1200 Milam

streaked clay, rock, sand

0 263

Houston (mailing address) 77002

sand

263 320

WELL LOCATION: 500' N + 20' E

No. 1 sec. 10 T. 10 N. R. 15 E of Eubanks Mize

clay

320 400

(distance) (direction) (nearest town)

WELL PURPOSE: oil field, some (home, irrigation, municipal, industrial)

INDEXED

WELL COMPLETION DATA:

(1) diameter (inches) 4"

(2) total depth (feet) 400'

(3) static water level (feet) 50' below top of ground.

(4) casing steel, 315' (material) (depth)

4" (size) If telescope see back.

(5) screen 42', 273' (length) (depth to top)

4" perforated (size) (material)

(6) pump AC (HP) 75 (yield gpm)

AC (type power)

(7) electric log (yes or no)

(organization running log)

(8) how well bottom plugged orange

peel

DRILLERS REMARKS:


DEPT. OF NATURAL RESOURCES BUREAU OF LAND & WATER RESOURCES

MAR 31 1981

RECEIVED

If well telescopes please sketch and show depths.

GROUND LEVEL

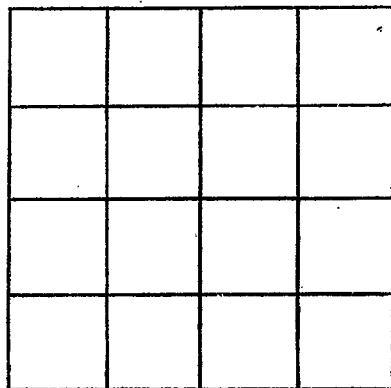

SECTION _____

Please indicate well location X.

ADDITIONAL INFORMATION

If more than one screen, show locations of each on sketch.