

Smith
 35
 10/23/91

MISSISSIPPI
 BOARD OF WATER COMMISSIONERS
 416 North State Street
 Jackson, Mississippi 39201

CODED

WATER WELL DRILLERS LOG

Oct. 23 1981 Roy V West Dalg Smith
 date well completed firm name county well located

LANDOWNER:	description of formations encountered	from	to
Clyde Magee	SAND	0	21
	CLAY	21	68
	SAND CLAY STRKS	68	101
	SAND	101	125

(mailing address)

WELL LOCATION:
 sec. 28 T 10 N R 15 E
 S W
 10 miles SW of TAYLORSVILLE
 (distance) (direction) (nearest town)

WELL PURPOSE: HEAT PUMP
 (home, irrigation, municipal, industrial)

- WELL COMPLETION DATA:
- (1) diameter (inches) 4"
 - (2) total depth (feet) 125'
 - (3) static water level (feet) 35' below top of ground.
 - (4) casing PVC 105' (material) (depth)
 - (size) if telescope see back.
 - (5) screen 20' 105' (length) (depth to top)
 - 4" PVC (size) (material)
 - (6) pump 1 36' (HP) (yield gpm)
 - REA (type power)
 - (7) electric log NO (yes or no)
 - (organization running log)
 - (8) how well bottom plugged WASH VALUE

CODED

DEPT. OF NATURAL RESOURCES
 BUREAU OF LAND & WATER RESOURCES


NOV 10 1981

RECEIVED

DRILLERS REMARKS:

If well telescopes please sketch and show depths.

GROUND LEVEL

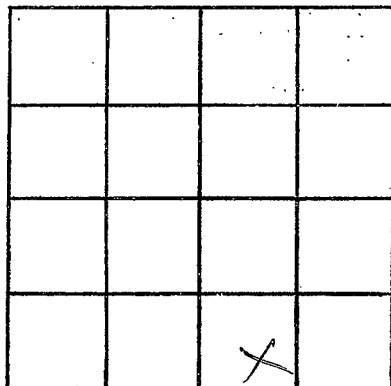

SECTION 28

Please indicate well location X.

ADDITIONAL INFORMATION

RECEIVED
87 NOV 10 AM 8:47

If more than one screen, show locations of each on sketch.