

MISSISSIPPI DEPARTMENT OF NATURAL RESOURCES

Bureau of Land and Water Resources

Southport Mall

P.O. Box 10631

Jackson, Mississippi 39209

WATER WELL DRILLERS LOG

CODED

SMITH  
 40  
 6-86

JUNE

1986 HERNDON WELL + SUPPLY

SMITH

date well completed

firm name

county well located

LANDOWNER: TOWN OF MIZE

description of formations encountered

from

to

MIZE, MISS.

(mailing address)

WELL LOCATION:

sec 6 T 10 N R 15 W

(distance) miles (direction) of (nearest town)

WELL PURPOSE: municipal  
 (home, irrigation, municipal, industrial)

WELL COMPLETION DATA:

- (1) diameter (inches) 12"
- (2) total depth (feet) 420
- (3) static water level (feet) 28' below top of ground.
- (4) casing STEEL, 390' (material) (depth)  
 12" (size) If telescope see back.
- (5) screen 30' length, 390' depth to top  
 6 (size) .010 SWT (material)
- (6) pump 20 (HP) 184 (yield gpm)  
 ELECTRIC (type power)
- (7) electric log YES (yes or no)  
 HERNDON WELL + SUPPLY INC (organization running log)

Top Soil	0	10
Sand + gravel	10	45
white clay	45	84
sandy shale	84	93
sand	93	125
clay	125	209
sandy shale	209	280
sand	280	320
shale	320	350
white chalk	350	363
shale	363	390
sand	390	425

RECEIVED  
 OCT 28 1986


Department of Natural Resources  
 Bureau of Land & Water Resources

DRILLERS REMARKS:

backwash valve

If well telescopes please sketch and show depths.

GROUND LEVEL

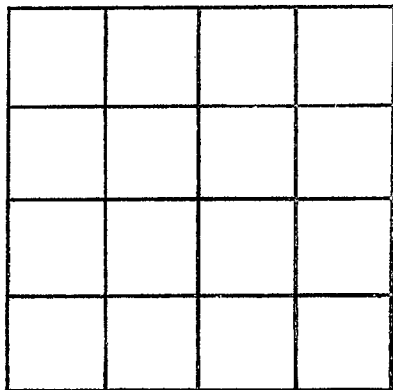

SECTION \_\_\_\_\_

Please indicate well location X.

ADDITIONAL INFORMATION

If more than one screen, show locations of each on sketch.