

MISSISSIPPI DEPARTMENT OF NATURAL RESOURCES

Bureau of Land and Water Resources

Southport Mall

P.O. Box 10631

Jackson, Mississippi 39209

WATER WELL DRILLERS LOG

CODED

Smith
 Q 41

4-25-86
 date well completed

Tom Griffith Well Service
 firm name

Smith, Ms
 county well located

LANDOWNER: Murco Drly Co
1900 Beck Building
Shreveport, La 71101
 (mailing address)

description of formations encountered	from	to
CLAY	0	18
SAND	18	55
CLAY	55	90
Hard Rock	90	91
Good SAND	91	195
Hard Rock	195	196
Streaked SAND	196	220
CLAY	220	305
SAND	305	320
CLAY	320	325
SAND	325	380

WELL LOCATION:
20.17 T 10 S R 15 E
13 miles NE of Mize, Ms
 (distance) (direction) (nearest town)


WELL PURPOSE: Oil LOCATION
 (home, irrigation, municipal, industrial)

WELL COMPLETION DATA:

- (1) diameter (inches) 3"
- (2) total depth (feet) 380'
- (3) static water level (feet) 90' ^{below} above top of ground.
- (4) casing PVC, 340
 (material) (depth)
N/A if telescope see back.
 (size)
- (5) screen 40, 340
 (length) (depth to top)
3", PVC
 (size) (material)
- (6) pump Arr, 65
 (HP) (yield gpm)
diesel
 (type power)
- (7) electric log No
 (yes or no)
NA
 (organization running log)
- (8) how well bottom plugged BWV

#1 JOHNSON-FEDERAL LAND

BANK 20-1
 1128'S E 1/4 OR NE 1/4 COR

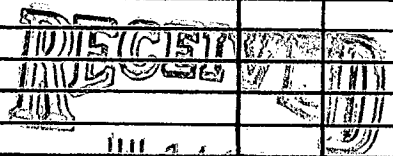


Department of Natural Resources
 Bureau of Land & Water Resources

DRILLERS REMARKS:
Drilled Two (2) Identical wells on this location

If well telescopes please sketch and show depths.

GROUND LEVEL

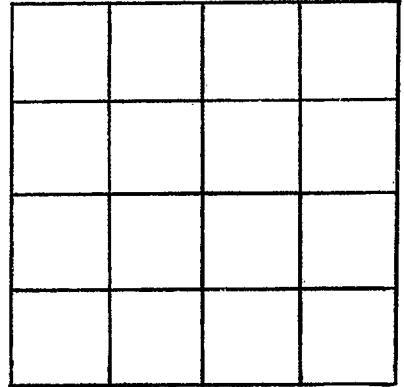

SECTION 17

Please indicate well location X.

ADDITIONAL INFORMATION

If more than one screen,
show locations of each on sketch.