

Smith
 Q2001
 6-2-76

MISSISSIPPI
 BOARD OF WATER COMMISSIONERS
 416 North State Street
 134 Jackson, Mississippi 39201

WATER WELL DRILLERS LOG

June 2 1976 W.K. Barnes Waterman Smith
 date well completed firm name county well located

LANDOWNER: Frank Barnes
 Rt. 1
 Taylorsville Miss
 (mailing address)

description of formations encountered	from	to
Red Clay	0	12
yellow clay	12	51
Fine Sand	51	72
yellow clay	72	96
Rock	96	104
yellow clay	104	190
Fine Sand	190	215
Course Sand	215	231

WELL LOCATION:
 sec. 30 T10 N S R15 E W
 10 miles SW of Taylorsville
 (distance) (direction) (nearest town)

WELL PURPOSE: Home
 (home, irrigation, municipal, industrial)


WELL COMPLETION DATA:
 (1) diameter (inches) 2
 (2) total depth (feet) 231
 (3) static water level (feet) 57 below top of ground.
 (4) casing Galv. 224 (material) (depth)
 2" (size) if telescope see back.
 (5) screen 8' (length) (depth to top)
 06 (size) Stainless S (material)
 (6) pump 1 (HP) 1.0 (yield gpm)
 Elec (type power)
 (7) electric log No (yes or no)
 (organization running log)
 (8) how well bottom plugged Wash valve

DRILLERS REMARKS:

RECEIVED
 JUN 16 1976
 MISS. BU. OF WATER
 OMM

If well telescopes please sketch and show depths.

GROUND LEVEL

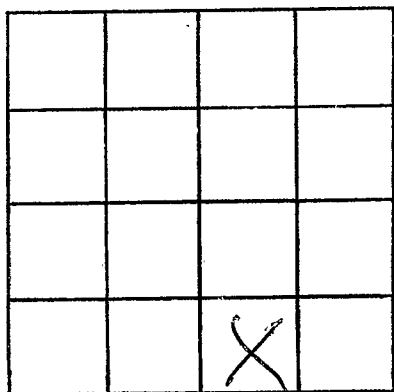

SECTION 30

Please indicate well location X.

ADDITIONAL INFORMATION

If more than one screen,
show locations of each on sketch.