

SMITH
 2002
 5/19/77

MISSISSIPPI
 BOARD OF WATER COMMISSIONERS
 416 North State Street
 Jackson, Mississippi 39201

WATER WELL DRILLERS LOG

132
 May 19-77 John Brown Water Well Drill Smith
 date well completed firm name county well located

LANDOWNER:
Jerry Lee Hand Sr.
R1 Intolive miss
 (mailing address)

description of formations encountered	from	to
	<u>sand</u>	<u>0</u>
	<u>10</u>	<u>20</u>
	<u>20</u>	<u>30</u>
	<u>30</u>	<u>40</u>
	<u>40</u>	<u>50</u>
	<u>50</u>	<u>60</u>
	<u>60</u>	<u>70</u>
	<u>70</u>	<u>80</u>
	<u>80</u>	<u>90</u>
	<u>90</u>	<u>100</u>

WELL LOCATION:
 sec. 33 T. 14 N. R. 15 E.
5 miles SE of Miss
 (distance) (direction) (nearest town)

WELL PURPOSE:
 (home, irrigation, municipal, industrial)

- WELL COMPLETION DATA:
- (1) diameter (inches) 4
 - (2) total depth (feet) 100
 - (3) static water level (feet) 55 below above top of ground.
 - (4) casing PVC 90
 (material) (depth)
 (size) if telescope see back.
 - (5) screen 10 90
 (length) (depth to top)
2x008 PVC
 (size) (material)
 - (6) pump 1 8
 (HP) (yield gpm)
220 VAC
 (type power)
 - (7) electric log NO
 (yes or no)
 - (organization running log)
 - (8) how well bottom plugged

DRILLERS REMARKS:


RECEIVED
 JUL 25 1977

MISS. Bd. OF WATER COMMISSIONERS

If well telescopes please sketch and show depths.

GROUND LEVEL

X
?

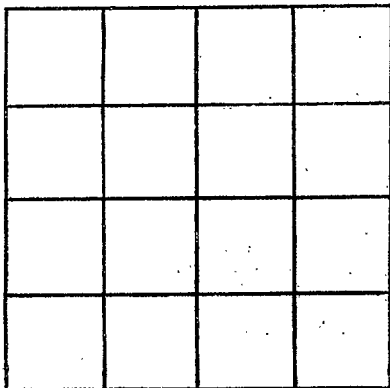

SECTION 33

Please indicate well location X.

ADDITIONAL INFORMATION

If more than one screen,
show locations of each on sketch.