

SMITH
 2003
 2/10/78

MISSISSIPPI
 BOARD OF WATER COMMISSIONERS
 416 North State Street
 Jackson, Mississippi 39201

WATER WELL DRILLERS LOG

Feb 10 1978 Roy Westwater Well Smith
 date well completed firm name county well located


LANDOWNER: Jimmy Jennings Rt 3 Jayloville Miss	description of fomations encountered	from	to
(mailing address)	Clay	0	12
	solid	12	28
	B. Clay	28	190
	rock	190	224

WELL LOCATION:
 sec. 15 T. 10 N. R. 8 E
 4 1/2 miles W of Jayloville
 (distance) (direction) (nearest town)

WELL PURPOSE: home
 (home, irrigation, municipal, industrial)


- WELL COMPLETION DATA:
- (1) diameter (inches) 2 1/2
 - (2) total depth (feet) 224
 - (3) static water level (feet) 115 below top of ground.
 - (4) casing PVC (material), (depth) (size) if telescope see back.
 - (5) screen 10 204 (length) (depth to top)
1/2" 2" steel (size) (material)
 - (6) pump 1/2 10 (HP) (yield gpm)
REA (type power)
 - (7) electric log No (yes or no)
(organization running log)
 - (8) how well bottom plugged wash water

DRILLERS REMARKS: FEB 21 1978

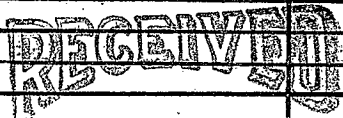

If well telescopes please sketch and show depths.

GROUND LEVEL

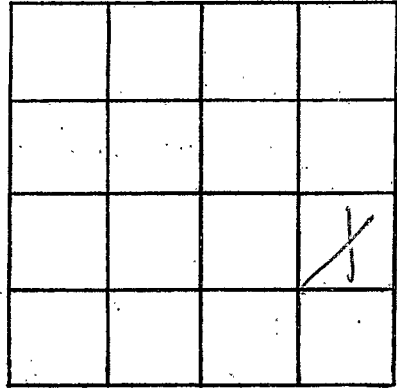

SECTION 157

Please indicate well location X.

ADDITIONAL INFORMATION

If more than one screen, show locations of each on sketch.