

Smith
 Q 2004
 1-2-80

MISSISSIPPI
 BOARD OF WATER COMMISSIONERS
 416 North State Street
 Jackson, Mississippi 39201

WATER WELL DRILLERS LOG

1-2 1980 Roy V West Drilling @ Smith
 date well completed firm name county well located

LANDOWNER: Steve Bortron
 P.O. Box 441
 Taylorsville MS
 (mailing address)

description of formations encountered	from	to
CLAY	0'	12'
SAND	12'	25'
CLAY	25'	80'
SAND	80'	115'

WELL LOCATION:
 sec. 4 T. 10 N. R. 15 E
 S W
 6 miles E of MIZE
 (distance) (direction) (nearest town)

WELL PURPOSE: HOME
 (home, irrigation, municipal, industrial)

- WELL COMPLETION DATA:
- (1) diameter (inches) 2"
 - (2) total depth (feet) 115
 - (3) static water level (feet) 22' below top of ground.
 - (4) casing PVC 110'
 (material) (depth)
 (size) If telescope see back.
 - (5) screen 5' 110'
 (length) (depth to top)
 1 1/2" stainless steel
 (size) (material)
 - (6) pump 1 8
 (HP) (yield gpm)
 Electric
 (type power)
 - (7) electric log NO
 (yes or no)
 (organization running log)
 - (8) how well bottom plugged WASH VALVE

DRILLERS REMARKS:


DEPT. OF NATURAL RESOURCES
 BUREAU OF LAND & WATER RESOURCES

JAN 25 1980

RECEIVED

If well telescopes please sketch and show depths.

GROUND LEVEL

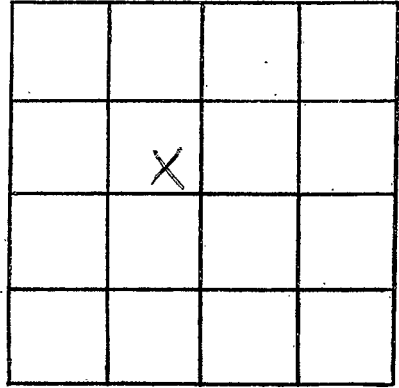

SECTION 4

Please indicate well location X.

ADDITIONAL INFORMATION

If more than one screen,
show locations of each on sketch.