

Smith  
Q 2005  
3-13-80

MISSISSIPPI  
BOARD OF WATER COMMISSIONERS  
416 North State Street  
Jackson, Mississippi 39201

WATER WELL DRILLERS LOG

3-13 date well completed 1980 Roy V West Drly firm name Smith county well located

LANDOWNER: L. B. Robinson  
Rt 3 Taylorsville MS  
(mailing address)

description of formations encountered	from	to
CLAY	0	11
SAND	11	20
CLAY	20	52
SAND	52	74

WELL LOCATION:  
sec 27 T 10 N R 15 E  
S W  
1 miles W of Taylorsville  
(distance) (direction) (nearest town)

WELL PURPOSE:  
(home, irrigation, municipal, industrial)

WELL COMPLETION DATA:

(1) diameter (inches) 4"  
(2) total depth (feet) 74'  
(3) static water level (feet) 60 below above top of ground.  
(4) casing PVC 64' (material) (depth)  
(size) If telescope see back.  
(5) screen 10' 64' (length) (depth to top)  
4" PVC (size) (material)  
(6) pump 1/2 20 (HP) (yield gpm)  
REA (type power)  
(7) electric log NO (yes or no)  
(organization running log)

(8) how well bottom plugged WASH W/IVE

DRILLERS REMARKS:


DEPT. OF NATURAL RESOURCES  
BUREAU OF LAND & WATER RESOURCES

MAR 24 1980

RECEIVED

If well telescopes please sketch and show depths.

GROUND LEVEL

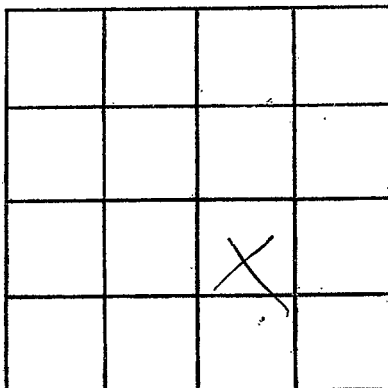

SECTION \_\_\_\_\_

Please indicate well location X.

ADDITIONAL INFORMATION

If more than one screen, show locations of each on sketch.