

SMITH
~~Smith~~
 2000
 B-24-80

MISSISSIPPI
 BOARD OF WATER COMMISSIONERS
 416 North State Street
 Jackson, Mississippi 39201

WATER WELL DRILLERS LOG

SMITH
~~Covington~~
 county well located

Aug 24 1980 date well completed
 Roy West Drlg firm name
 Covington county well located

| LANDOWNER: | description of formations encountered | from | to |
|-------------------|---------------------------------------|------|-----|
| David Clanton | | | |
| R+1 Mt. Olive | GRAVEL | 25 | 55 |
| (mailing address) | CLAY | 55 | 90 |
| | SAND | 90 | 130 |

WELL LOCATION:
 sec. 30 T 10 N R 15 E
5 S W
20 miles E of MT OLIVE
 (distance) (direction) (nearest town)

WELL PURPOSE: HOME
 (home, irrigation, municipal, industrial)


- WELL COMPLETION DATA:
- (1) diameter (inches) 2"
 - (2) total depth (feet) 130'
 - (3) static water level (feet) 80' below top of ground.
 - (4) casing PVC, 125'
 (material) (depth)
 (size) If telescope see back.
 - (5) screen 5', 125'
 (length) (depth to top)
1/4", STAINLESS STEEL
 (size) (material)
 - (6) pump 1 5
 (HP) (yield gpm)
REA
 (type power)
 - (7) electric log NO
 (yes or no)
 (organization running log)
 - (8) how well bottom plugged WASH VALUE

DEPT. OF NATURAL RESOURCES
 BUREAU OF LAND & WATER RESOURCES
 SEP 11 1980
 RECEIVED

DRILLERS REMARKS:

If well telescopes please sketch and show depths.

GROUND LEVEL

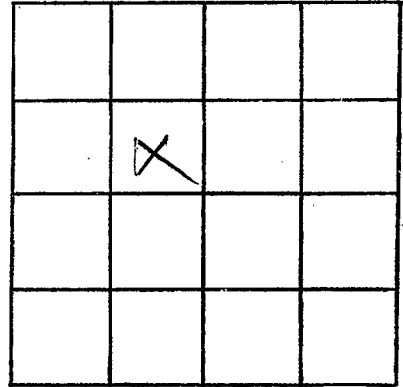

SECTION _____

Please indicate well location X.

ADDITIONAL INFORMATION

If more than one screen,
show locations of each on sketch.