

Smith  
Q2007

MISSISSIPPI  
BOARD OF WATER COMMISSIONERS  
416 North State Street  
Jackson, Mississippi 39201

WATER WELL DRILLERS LOG

date well completed 1982 Roy V. West Drlg firm name Smith county well located

LANDOWNER:	description of formations encountered	from	to
<u>Robert Robinson</u>		<u>CLAY</u>	<u>0</u>
<u>Taylorville</u> (mailing address)	<u>SAND</u>	<u>52</u>	<u>72</u>
<b>WELL LOCATION:</b>			
sec. <u>24</u> T <u>10</u> N R <u>15</u> E			
<u>1/2</u> miles <u>W</u> of <u>Taylorville</u>			
(distance) (direction) (nearest town)			
<b>WELL PURPOSE:</b> <u>Home</u> (home, irrigation, municipal, industrial)			
<b>WELL COMPLETION DATA:</b>			
(1) diameter (inches) <u>2"</u>			
(2) total depth (feet) <u>73'</u>			
(3) static water level (feet) <u>62'</u> below above top of ground.			
(4) casing <u>PVC</u> (material), (depth)			
(size) if telescope see back.			
(5) screen <u>5'</u> <u>68'</u> (length) (depth to top)			
<u>2"</u> <u>PVC</u> (size) (material)			
(6) pump <u>3/4</u> <u>7</u> (HP) (yield gpm)			
<u>REA</u> (type power)			
(7) electric log <u>NO</u> (yes or no)			
(organization running log)			
(8) how well bottom plugged <u>WASH VALVE</u>			
DRILLERS REMARKS:			


DEPT. OF NATURAL RESOURCES  
BUREAU OF LAND & WATER RESOURCES

JUL 19 1982

RECEIVED

If well telescopes please sketch and show depths.

GROUND LEVEL

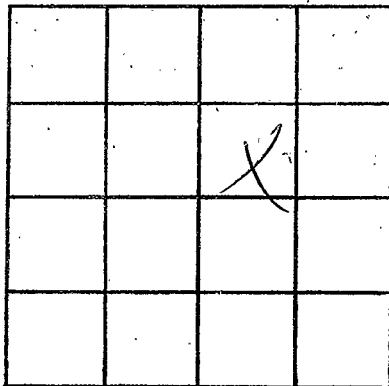

SECTION 24

Please indicate well location X.

ADDITIONAL INFORMATION

If more than one screen,  
show locations of each on sketch.