

Smith
Q2008

MISSISSIPPI
BOARD OF WATER COMMISSIONERS
416 North State Street
Jackson, Mississippi 39201

WATER WELL DRILLERS LOG

JUNE 29 1984 Ray UNVEST Dely Smith
date well completed firm name county well located

LANDOWNER:	description of formations encountered	from	to
RAYMOND HORNE	Top Soil	0	2
LAUREL MS (mailing address)	GRAVEL	2	38
	CLAY	38	160
	SAND	160	240
WELL LOCATION:			
sec. <u>S 10</u> <u>N</u> R. <u>15</u> <u>E</u> <u>S</u> <u>W</u> <u>1</u> miles <u>N</u> of <u>TAYLORSVILLE</u> (distance) (direction) (nearest town)			
WELL PURPOSE: (home, irrigation, municipal, industrial)			
WELL COMPLETION DATA:			
(1) diameter (inches) <u>2"</u>			
(2) total depth (feet) <u>230'</u>			
(3) static water level (feet) <u>28'</u> below above top of ground.			
(4) casing <u>PVC</u> , <u>220'</u> (material) (depth)			
_____ if telescope see back. (size)			
(5) screen <u>10'</u> , <u>220'</u> (length) (depth to top)			
<u>2"</u> , <u>PVC</u> (size) (material)			
(6) pump <u>1</u> , <u>10</u> (HP) (yield gpm)			
<u>REA</u> (type power)			
(7) electric log <u>NO</u> (yes or no)			
_____ (organization running log)			
(8) how well bottom plugged <u>WASH VALVE</u>			
DRILLERS REMARKS: <u>Did not bottom</u> <u>SAND</u>			


MISSISSIPPI DEPT. OF NATURAL RESOURCES
BUREAU OF LAND & WATER RESOURCES

AUG 3 1984

RECEIVED

If well telescopes please sketch and show depths.

GROUND LEVEL

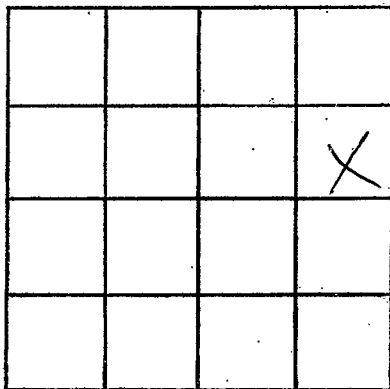

SECTION 5

Please indicate well location X.

ADDITIONAL INFORMATION

If more than one screen, show locations of each on sketch.