

MISSISSIPPI DEPARTMENT OF NATURAL RESOURCES
Bureau of Land and Water Resources

P.O. Box 10631
Jackson, Mississippi 39209
WATER WELL DRILLERS LOG

COUNTY WELL LOCATED Smith	
WELL NUMBER 9	CODED
DATE WELL COMPLETED 2005 5-27-88	

PERMIT NUMBER
NAME OF DRILLING FIRM Roy V. West Daily

NAME & MAILING ADDRESS OF LANDOWNER Collins Taylorsville MS			
WELL LOCATION:	SEC	TOWNSHIP	RANGE
	20	10^N S	15^E W
DISTANCE	DIRECTION	NEAREST TOWN	
0 Miles	S	of Taylorsville	
OTHER LANDMARK Inside Taylorsville			
WELL PURPOSE: <u>Home Irrigation, Municipal, Industrial, Fish Pond, etc.</u>			

PUMP DATA		
PUMP TYPE (Circle One): Submersible, Turbine, Jet Flowing Well, Other (Describe) _____		
POWER TYPE (Circle One): Electric, Tractor, Diesel, Gasoline, Butane, Other (Describe) _____		
Pump Capacity (GPM)	No. of Stages	Setting Depth
12	2	40 FT.
PUMP TEST		
Well yielded 12 GPM with a drawdown of _____ ft. after _____ hours of pumping		

WELL DATA		
Well Depth 98'	Casing Diameter (In.) 2"	Casing Length (Ft.) 93'
Type of Casing PVC	Hole Depth 98'	Depth to Static Water Level 13'
TYPE OF COMPLETION: (Circle One or More): <u>Gravel Packed</u> , Underreamed, Telescoped, <u>Natural Development</u> , Open Hole, Other		
Top of Lap Pipe or Reduction in Casing FEET IF TELESCOPED OR MORE THAN ONE SCREEN: USE BACK PAGE		

LOG DATA	
TYPE OF LOG RUN (Circle One): Electric, Gamma Ray, Density, Sonic, Neutron, Other (Describe) _____	
No Log Run	
Name of Organization Running Log	

SCREEN DATA		
Diameter - Inches 2"	Length - Feet 5'	Slot Size - Inches .008
Screen Type PVC	Depth to Bottom - Feet 98'	


GEOLOGIC DATA (Office Use Only)			
Surface Elev.	Geologic Unit	Unit Thickness	Depth to Top
Subs. SWL	Date	Analysis	Aquifer Test

Driller's Remarks

DESCRIPTION OF FORMATIONS ENCOUNTERED	FROM	TO	FORMATIONS (Continued)	FROM	TO
SANDY CLAY	0	6	RECEIVED		
CLAY	6	12			
SAND	12	98			
			JAN 11 1989		
			Department of Natural Resources Bureau of Land & Water Resources		
IF MORE SPACE IS NEEDED, USE BACK					

If well telescopes please sketch and show depths.

GROUND LEVEL

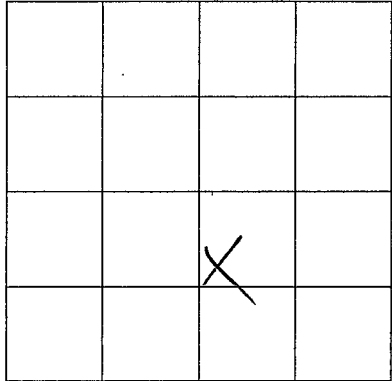

SECTION 20

Please indicate well location X.

ADDITIONAL INFORMATION

Lined area for additional information.

If more than one screen, show location of each on sketch.