

MISSISSIPPI DEPARTMENT OF NATURAL RESOURCES

Bureau of Land and Water Resources

P.O. Box 10631

Jackson, Mississippi 39209

WATER WELL DRILLERS LOG

COUNTY WELL LOCATED	
SMITH WELL NUMBER	CODED
9	
2003	
DATE WELL COMPLETED	
8-24-90	

PERMIT NUMBER
NAME OF DRILLING FIRM
Roy V. West

NAME & MAILING ADDRESS OF LANDOWNER		
Hancock Lumber		
Mize MS.		
WELL LOCATION:	SEC	TOWNSHIP RANGE
	5	10 ^N / _S 15 ^E / _W
DISTANCE	DIRECTION	NEAREST TOWN
1	Miles E	of MIZE
OTHER LANDMARK		
WELL PURPOSE: Home, Irrigation, Municipal, Industrial, Fish Pond, etc.		
WOODYARD		

PUMP DATA		
PUMP TYPE (Circle One):		
Submersible, Turbine, Jet, Flowing Well,		
Other (Describe) _____		
POWER TYPE (Circle One):		
Electric, Tractor, Diesel, Gasoline, Butane,		
Other (Describe) _____ H/P <u>3</u>		
Pump Capacity (GPM)	No. of Stages	Setting Depth
80		80' FT.
PUMP TEST		
Well yielded _____ GPM with		
a drawdown of _____ ft.		
after _____ hours of pumping		

WELL DATA		
Well Depth	Casing Diameter (In.)	Casing Length (Ft.)
130'	4"	110'
Type of Casing	Hole Depth	Depth to Static Water Level
PVC	130'	35'
TYPE OF COMPLETION: (Circle One or More):		
Gravel Packed, Underreamed, Telescoped,		
Natural Development, Open Hole, Other		
(Describe) _____		
Top of Lap Pipe or Reduction in Casing		
FEET		
IF TELESCOPED OR MORE THAN ONE SCREEN: USE BACK PAGE		

LOG DATA	
TYPE OF LOG RUN (Circle One):	
Electric, Gamma Ray, Density, Sonic, Neutron,	
Other (Describe) _____	
No Log Run	
Name of Organization Running Log	

SCREEN DATA		
Diameter - Inches	Length - Feet	Slot Size - Inches
4"	20	.010
Screen Type	Depth to Bottom - Feet	
PVC	130'	

GEOLOGIC DATA (Office Use Only)			
Surface Elev.	Geologic Unit	Unit Thickness	Depth to Top
Subs. SWL	Date	Analysis	Aquifer Test


Driller's Remarks

DESCRIPTION OF FORMATIONS ENCOUNTERED	FROM	TO	FORMATIONS (Continued)	FROM	TO
CLAY	0	35	<div style="font-size: 2em; font-weight: bold; opacity: 0.5;">RECEIVED</div> <div style="font-size: 1.5em; font-weight: bold; margin-top: 10px;">NOV 19 1990</div> <div style="font-size: 0.8em; font-weight: bold; margin-top: 10px;">Department of Natural Resources Bureau of Land & Water Resources</div>		
SAND & GRAVEL	35	130			

IF MORE SPACE IS NEEDED, USE BACK

If well telescopes please sketch and show depths.

GROUND LEVEL

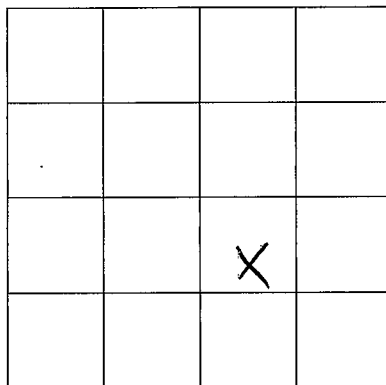

SECTION 5

Please indicate well location X.

ADDITIONAL INFORMATION

If more than one screen,
show location of each on sketch.