

MISSISSIPPI DEPARTMENT OF ENVIRONMENTAL QUALITY
Bureau of Land and Water Resources

P. O. Box 10631
Jackson, MS 39289-0631
WATER WELL DRILLERS LOG

COUNTY WELL LOCATED SMITH	
WELL NUMBER Q	CODED
DATE WELL COMPLETED 2014 2-3-93	

PERMIT NUMBER
NAME OF DRILLING FIRM PARKER WELL SERVICE

NAME & MAILING ADDRESS OF LANDOWNER CLYDE MAGEE MIZE MS.			
WELL LOCATION:	SEC 28	TOWNSHIP 10	RANGE 15
DISTANCE 6 Miles	DIRECTION South EAST	NEAREST TOWN MIZE	
OTHER LANDMARK Fellowship Church			
WELL PURPOSE: Home Irrigation, Municipal, Industrial, Fish Pond, etc.			

PUMP DATA			
PUMP TYPE (Circle One): <input checked="" type="radio"/> Submersible Turbine, Jet Flowing Well, Other (Describe) _____			
POWER TYPE (Circle One): Electric, Tractor, Diesel, Gasoline, Butane, Other (Describe) _____ H/P 15			
Pump Capacity (GPM) 35	No. of Stages 12	Setting Depth 70'	FT.
PUMP TEST			
Well yielded 44 GPM with a drawdown of 0 ft. after 3 hours of pumping			

WELL DATA		
Well Depth 80	Casing Diameter (In.) 4"	Casing Length (Ft.) 60'
Type of Casing PVC	Hole Depth 80	Depth to Static Water Level 10'
TYPE OF COMPLETION: (Circle One or More): Gravel Packed, Underreamed, Telescoped, <input checked="" type="radio"/> Natural Development, Open Hole, Other		
Top of Lap Pipe or Reduction in Casing FEET IF TELESCOPED OR MORE THAN ONE SCREEN: USE BACK PAGE		

LOG DATA	
TYPE OF LOG RUN (Circle One): No Log Run, Electric, Gamma Ray, Density, Sonic, Neutron, Other (Describe) _____	
Name of Organization Running Log	

SCREEN DATA		
Diameter - Inches 4"	Length - Feet 20'	Slot Size - Inches 008
Screen Type PVC	Depth to Bottom - Feet 80	

GEOLOGIC DATA (Office Use Only)			
Surface Elev.	Geologic Unit	Unit Thickness	Depth to Top
Subs. SWL	Date	Analysis	Aquifer Test

Driller's Remarks REAL CORSE SAND CLOSE TO CREEK


DESCRIPTION OF FORMATIONS ENCOUNTERED	FROM	TO
CLAY	0	20
SAND	20	80

FORMATIONS (Continued)	FROM	TO
RECEIVED		
FEB 18 1993		
Dept. of Environmental Quality Office of Land & Water Resources		
IF MORE SPACE IS NEEDED, USE BACK		

If well telescopes please sketch and show depths.

GROUND LEVEL

T102

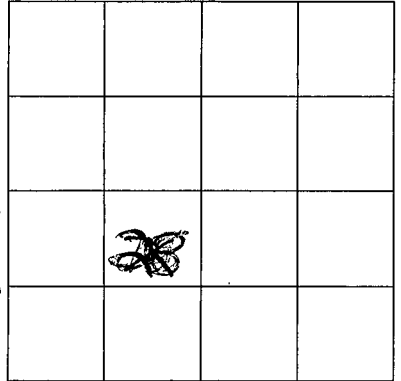

R15W

SECTION 28

Please indicate well location X.

ADDITIONAL INFORMATION

GO TO MIZE SOUTH
ON 35 HW. GO TO
FIRST CROSS ROADS
TAKE LEFT GO 4
MILES TO CLYDE MIZE
PLACE. HOUSE ON
RIGHT GOING DOWN
BIG HILL

If more than one screen,
show location of each on sketch.