

MISSISSIPPI DEPARTMENT OF ENVIRONMENTAL QUALITY
Bureau of Land and Water Resources

P. O. Box 10631
Jackson, MS 39289-0631
WATER WELL DRILLERS LOG

COUNTY WELL LOCATED SMITH	
WELL NUMBER 2015	CODED
DATE WELL COMPLETED 3-25-94	

PERMIT NUMBER
NAME OF DRILLING FIRM PARKER WELL SERVICE

NAME & MAILING ADDRESS OF LANDOWNER CLYDE MAGEE MIZE MISS

PUMP DATA		
PUMP TYPE (Circle One): <input checked="" type="radio"/> Submersible, <input type="radio"/> Turbine, <input type="radio"/> Jet, <input type="radio"/> Flowing Well, Other (Describe) _____		
POWER TYPE (Circle One): <input checked="" type="radio"/> Electric, <input type="radio"/> Tractor, <input type="radio"/> Diesel, <input type="radio"/> Gasoline, <input type="radio"/> Butane, Other (Describe) _____		
Pump Capacity (GPM) 20	No. of Stages 9	Setting Depth 120' FT.
PUMP TEST Well yielded 30 GPM with a drawdown of 20' ft. after 6 hours of pumping		

WELL LOCATION: SEC 28 TOWNSHIP T10 RANGE R15
DISTANCE 8 Miles DIRECTION SOUTH of NEAREST TOWN TALLOYSVILLE
OTHER LANDMARK
WELL PURPOSE: Home <input checked="" type="radio"/> Irrigation <input type="radio"/> Municipal, Industrial, Fish Pond, etc.

WELL DATA		
Well Depth 134'	Casing Diameter (In.) 4"	Casing Length (Ft.) 114'
Type of Casing PVC	Hole Depth 134'	Depth to Static Water Level 60'
TYPE OF COMPLETION: (Circle One or More): <input checked="" type="radio"/> Gravel Packed, <input type="radio"/> Underreamed, <input type="radio"/> Telescoped, <input checked="" type="radio"/> Natural Development, <input type="radio"/> Open Hole, <input type="radio"/> Other (Describe) _____		
Top of Lap Pipe or Reduction in Casing FEET IF TELESCOPED OR MORE THAN ONE SCREEN: USE BACK PAGE		

LOG DATA	
TYPE OF LOG RUN (Circle One): <input type="radio"/> No Log Run, <input type="radio"/> Electric, <input type="radio"/> Gamma Ray, <input type="radio"/> Density, <input type="radio"/> Sonic, <input type="radio"/> Neutron, Other (Describe) _____	
Name of Organization Running Log	

SCREEN DATA		
Diameter - Inches 4"	Length - Feet 20'	Slot Size - Inches 006
Screen Type PVC	Depth to Bottom - Feet 134'	


GEOLOGIC DATA (Office Use Only)			
Surface Elev.	Geologic Unit	Unit Thickness	Depth to Top
Subs. SWL	Date	Analysis	Aquifer Test
Driller's Remarks			

DESCRIPTION OF FORMATIONS ENCOUNTERED	FROM	TO	FORMATIONS (Continued)	FROM	TO
Red Sand	0	90	RECEIVED APR 01 1994 Dept. of Environmental Quality Office of Land & Water Resources		
CLAY	90	114			
SAND	114	134			

IF MORE SPACE IS NEEDED, USE BACK

If well telescopes please
sketch and show depths.

GROUND LEVEL

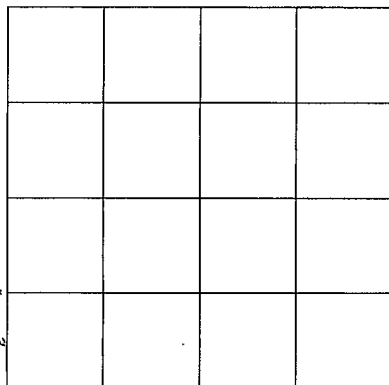

R15W
SECTION 28

Please indicate well location X.

ADDITIONAL INFORMATION

GO TO TAYLORSVILLE
ON #28 TAKE
RIGHT AT END OF
PARK GO BY
PLANTS GO
TO END ROAD
TAKE RIGHT
GO 1 MI. WELL
IN TOMATO
FIELD ON
HILL

If more than one screen,
show location of each on sketch.