


This is
R6B T.M.C.A. 0

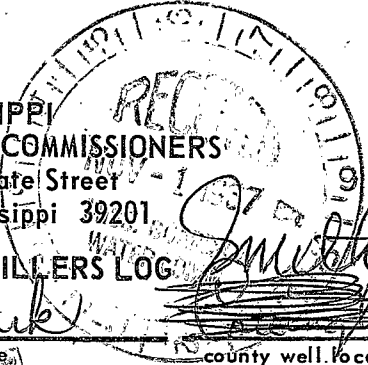

MISSISSIPPI
BOARD OF WATER COMMISSIONERS
416 North State Street
Jackson, Mississippi 39201

WATER WELL DRILLERS LOG

Smith

v R6b

2-67

Elec Log

2/22

date well completed

R6B

17

C.S. Clark

firm name

county well located

LANDOWNER:

fellowship

description of formations encountered

from to

Metcuse
Tupersville Miss
(mailing address)

Red Sandy Clay	0	8
Red Sand	8	22
White Sand	22	36
White Sand & Sea Sand	36	46
White Clay	46	80
Blue Clay	80	159
Medium & Coarse Sand	159	214
Sandy Clay	214	230
Blue Clay	230	276
Sandy Clay	276	300
Clay	300	370
Sandy Clay	370	386
Clay, Sand & Shells	386	395
Loose Circulation	395	
Clay Shells & Sand	395	400
Coarse Sand	400	440
Sticky Clay	440	449
Sandy Clay	449	480
Clay	480	700

WELL LOCATION:

sec. 18 T10 R14 E
S NW of Tupersville
(distance) (direction) (nearest town)

WELL PURPOSE:

Test hole
(home, irrigation, municipal, industrial)

WELL COMPLETION DATA:


- (1) diameter (inches) 4 in
- (2) total depth (feet) 470
- (3) static water level (feet) 100 below above top of ground.
- (4) casing 4 1/2" Black! (material) (depth)
2 in if telescope see back. (size)
- (5) screen 20 420 (length) (depth to top)
2 in SIS (size) (material)
- (6) pump 3 600 G.P.M (HP) (yield gpm)
R.E.A (type power)
- (7) electric log (yes or no)
State Geo Survey (organization running log)
- (8) how well bottom plugged Sand

DRILLERS REMARKS:

If well telescopes please sketch and show depths.


GROUND LEVEL

crush pipe

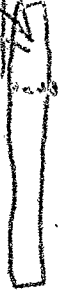

20 ft screen
4 in casing 400 ft

2 ft with
level hander
10 ft casing pipe

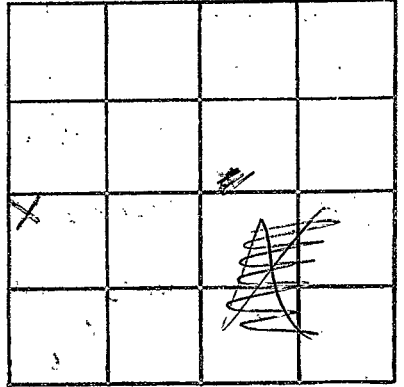

18

SECTION ~~18~~

Please indicate well location X.

ADDITIONAL INFORMATION

Multiple horizontal lines for recording additional information.

If more than one screen, show locations of each on sketch.