

SMITH

0

4 R 7 MISSISSIPPI BOARD OF WATER COMMISSIONERS
5-11-66

CODED

WATER WELL DRILLERS LOG

Date 5-11, 1966, Driller: LEACH County Smith
(When well drilled) (Name) (Where well is located)

(1) Owner of Land: Mrs Annie Stringer
(Name)
Stringer Miss
(Address)
(2) Location: 1/4, 1/4, Sec. 17 ^{10N 13W} T R,
5 miles West, of Stringer,
(distance) (direction) (Nearest Town)
(3) Topography: (hilly) (Flat) (Level)
(4) Purpose of Well: (Domestic Irrigation)
 (Municipal, Industrial, Other)


Description & Color of Materials Sand, Clay, Red Clay, Shell, etc.	Thick- ness Feet	Depth Feet
<u>Clay</u>	<u>10</u>	<u>16</u>
<u>Sand & gravel</u>	<u>60</u>	<u>70</u>
<u>Sand</u>	<u>10</u>	<u>80</u>

Information upon completion of well:

(1) Diameter 2 inches.
(2) Total Depth 80 feet.
(3) Water Level 50 feet below top of ground.
(4) Cased to 75', Size 2"
(5) Screen: Size 2", Length 5'
(6) Were any formations sealed against pollution?
_____ yes, _____ no.

If YES depth of formation _____
Why _____

Drillers Remarks: _____
Yield in gpm: 6
Size pump: 3 HP
Type power: 4

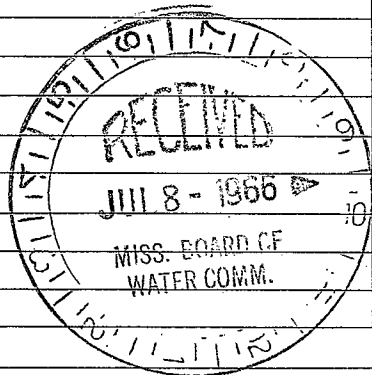

Total 80

