

SMITH

WATER WELL DRILLERS LOG

CODED Smith Co.?

6 R 9
10-11-60

Date: 10-11, 1960, Driller: W. K. Barnes County Jasper
(Name)

(1) Owner of Land:	Description & Color of Materials Sand, Clay, Red Clay, Shell, etc.	Thick- ness Feet	Depth Feet
Harold Jones (Name)	Red clay	0	25
Summerland Miss (Address)	Sand & Gravel	25	41
(2) Location: 1/4, 1/4, Sec. 16 N. 14 W. T. R.			
5 miles north of Summerland (distance) (direction) (Nearest Town)			
(3) Topography: Flat (Hilly) (Flat) (Level)			
(4) Purpose of Well: Home use (Domestic Irrigation Municipal, Industrial, Other)			


Information upon completion of well:

- (1) Diameter 2 inches.
- (2) Total Depth 41 feet.
- (3) Water Level 25 feet below top of ground.
- (4) Cased to 35, Size 2.
- (5) Screen: Size 80, Length 6.
- (6) Were any formations sealed against pollution?
_____ yes, _____ no.

If YES depth of formation _____

Why _____

Drillers Remarks: _____

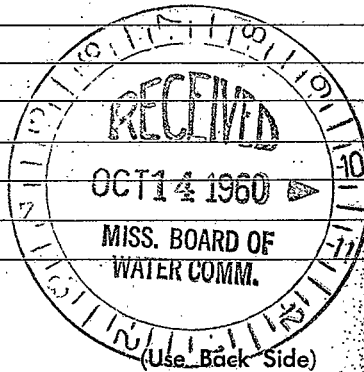

Well No. _____

