

C. P. CLARK
WATER WELL DRILLING
 ROUTE 2

MISSISSIPPI
 BOARD OF WATER COMMISSIONERS
 416 North State Street
 Jackson, Mississippi 39201

LAUREL, MISS. 39440

CODED

WATER WELL DRILLERS LOG

SMITH
 R 12
 3-68

C.P. Clark

Smith

3/21 1968
 date well completed

firm name

county well located

LANDOWNER: Automatic Plating

Co. Box 641 Taylorsville

Miss

(mailing address)

WELL LOCATION:

sec. 18 T. 10N S. R. 14E W.
1/2 miles NW of Taylorsville
 (distance) (direction) (nearest town)

WELL PURPOSE: Industrial
 (home, irrigation, municipal, industrial)

WELL COMPLETION DATA:

(1) diameter (inches) 4 x 2 1/2

(2) total depth (feet) 395

(3) static water level (feet) 65 Below above top of ground.

(4) casing Galvneon 345
 (material) (depth)

2 1/2 if telescope see back.
 (size)

(5) screen 10 385
 (length) (depth to top)

2 1/2 S.S.
 (size) (material)

(6) pump 5 120
 (HP) (yield gpm)

220V 3 Phase
 (type power)

(7) electric log No
 (yes or no)


(organization running log)

(8) how well bottom plugged

description of formations encountered

from to

<u>Sandy Clay</u>	<u>0</u>	<u>10</u>
<u>Sand</u>	<u>10</u>	<u>30</u>
<u>Sandy Clay</u>	<u>30</u>	<u>43</u>
<u>Clay Grey</u>	<u>43</u>	<u>80</u>
<u>Blue Clay</u>	<u>80</u>	<u>151</u>
<u>Sand</u>	<u>151</u>	<u>205</u>
<u>Sandy Clay</u>	<u>205</u>	<u>225</u>
<u>Blue & Green Clay</u>	<u>225</u>	<u>345</u>
<u>Good sand</u>	<u>345</u>	<u>395</u>

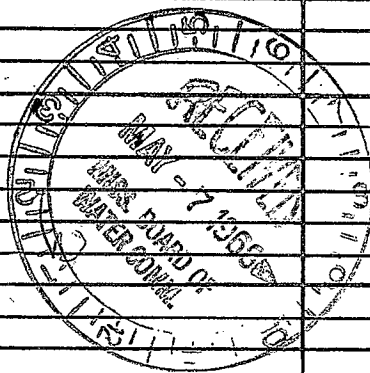

DRILLERS REMARKS:

