

SMITH  
R13  
11-6-70

MISSISSIPPI  
BOARD OF WATER COMMISSIONERS  
416 North State Street  
Jackson, Mississippi 39201

**CODED**

WATER WELL DRILLERS LOG

11-6 1970 Wk. Barnes Waterwell Smith  
date well completed firm name county well located

LANDOWNER: Mrs. P. H. Boyd  
Tomborsville Miss  
Route 3  
(mailing address)

description of formations encountered	from	to
yellow soil	0	8
fine sand	8	14
Blue Clay	14	28
fine sand	28	42
Blue Clay	42	142
rock	142	148
Blue Clay	148	260
rock	260	262
Blue Clay	262	268
fine sand	268	302

WELL LOCATION:  
sec. 16 T 10 (N) R 14 E  
S W  
1 miles E of Tomborsville  
(distance) (direction) (nearest town)

WELL PURPOSE: HOME  
(home, irrigation, municipal, industrial)

- WELL COMPLETION DATA:
- (1) diameter (inches) 2"
  - (2) total depth (feet) 302
  - (3) static water level (feet) 7 below top of ground
  - (4) casing Galv. (material), (depth) 2" if telescope see back (size)
  - (5) screen 4' (length), (depth to top) 8.5' (size), (material)
  - (6) pump 1/3 (HP), 8 (yield gpm)  
Elec. (type power)
  - (7) electric log yes (yes or no)  
(organization running log)
  - (8) how well bottom plugged 70%

**CODED**


NOV 18 1970

DRILLERS REMARKS:

MISS. BD. OF  
WATER COMM.

If well telescopes please sketch and show depths.

GROUND LEVEL

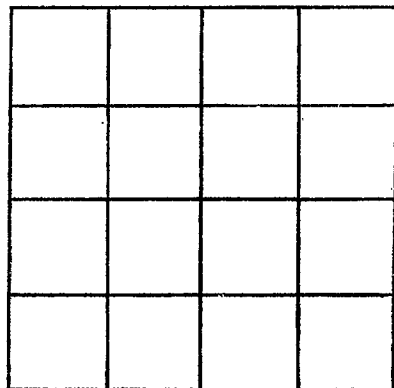

SECTION 16

Please indicate well location X.

ADDITIONAL INFORMATION

If more than one screen,  
show locations of each on sketch.