

**MISSISSIPPI
BOARD OF WATER COMMISSIONERS**
416 North State Street
Jackson, Mississippi 39201

WATER WELL DRILLERS LOG

Smith
R-11 CODED
268

7-27 1968 W.K. Barnes Water Wells Smith
date well completed firm name county well located

LANDOWNER: Elliot Brown
Route 3
Taylorville Miss
(mailing address)

description of formations encountered	from	to
<u>red clay</u>	<u>0</u>	<u>10</u>
<u>red sand</u>	<u>10</u>	<u>25</u>
<u>yellow</u>	<u>25</u>	<u>80</u>
<u>Sand Rock</u>	<u>80</u>	<u>82</u>
<u>yellow clay</u>	<u>82</u>	<u>110</u>
<u>fine sand</u>	<u>110</u>	<u>130</u>
<u>Course Sand</u>	<u>130</u>	<u>155</u>

WELL LOCATION:
sec. 11 T. 10 N. R. 14 E.
S. W.
4 miles North of Taylorville
(distance) (direction) (nearest town)

WELL PURPOSE: Home use
(home, irrigation, municipal, industrial)

WELL COMPLETION DATA:

(1) diameter (inches) 2

(2) total depth (feet) 155

(3) static water level (feet) 42 below above top of ground.

(4) casing Galv. 150
(material) (depth)
1 1/4 if telescope see back.
(size)

(5) screen 5' 150
(length) (depth to top)
1 1/4 Stainless Steel
(size) (material)

(6) pump 3/4 10
(HP) (yield gpm)
Elec.
(type power)

(7) electric log NO.
(yes or no)

(organization running log)

(8) how well bottom plugged Washed

DRILLERS REMARKS:


CODED

AUG 8 1968

MISS. BD. OF
WATER COMM.

If well telescopes please sketch and show depths.

GROUND LEVEL

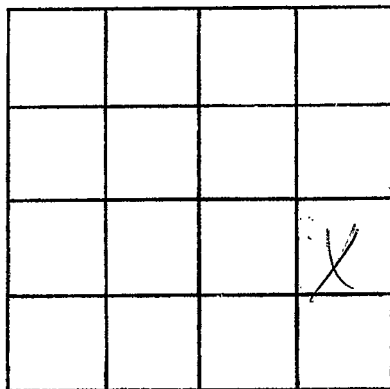

SECTION 11

Please indicate well location X.

ADDITIONAL INFORMATION

If more than one screen, show locations of each on sketch.