

SMITH
 R 19 CODED
 7-68

MISSISSIPPI
 BOARD OF WATER COMMISSIONERS
 416 North State Street
 Jackson, Mississippi 39201

WATER WELL DRILLERS LOG

7-9 1968 W.K. Barnes water wells smiths
 date well completed firm name county well located

LANDOWNER: Pine Valley Church
 Route 3
 Taylorsville miss
 (mailing address)

description of formations encountered	from	to
red clay	0	10
yellow clay	10	20
fine sand	20	42
course sand	42	74

WELL LOCATION:
 sec. 30 T. 10 N. R. 13 E.
 2 miles north of Summerland
 (distance) (direction) (nearest town)

WELL PURPOSE: Church
 (home, irrigation, municipal, industrial)

WELL COMPLETION DATA:

(1) diameter (inches) 2

(2) total depth (feet) 74

(3) static water level (feet) 30 below top of ground.

(4) casing Galv. 20 (material) (depth)
 2" If telescope see back. (size)

(5) screen 4 ft. (length) (depth to top)
 2" Stainless Steel (size) (material)

(6) pump 3/4 (HP) 14 (yield gpm)
 elec (type power)

(7) electric log no. (yes or no)

(organization running log)

CODED

(8) how well bottom plugged Wash valve


AUG 8 1968

DRILLERS REMARKS:

MISS. BD. OF
 WATER COMMISSIONERS

If well telescopes please sketch and show depths.

GROUND LEVEL

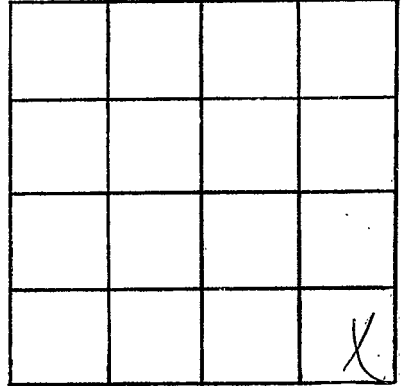

SECTION 30

Please indicate well location X.

ADDITIONAL INFORMATION

If more than one screen, show locations of each on sketch.