

Smith
 R20
 8-28-68

MISSISSIPPI
 BOARD OF WATER COMMISSIONERS
 416 North State Street
 Jackson, Mississippi 39201

WATER WELL DRILLERS LOG

Henshell TAYLOR WATER
 WELL DRILLING

Smith

Aug. 28 1968 date well completed
 Henshell TAYLOR WATER WELL DRILLING firm name
 Smith county well located

LANDOWNER: Mr. D. L. Foster

description of formations encountered

from to

Rt. 2
 Taylorsville, Miss.
 (mailing address)

red sand 0 40
 shell chalk 40 90
 lime rock 90 92
 fine sand 92 115
 coarse sand 115 120

WELL LOCATION:


sec. 27 T. 126 S. R. 14 E. W.
 1 1/2 miles N.W. of Sumner
 (distance) (direction) (nearest town)

WELL PURPOSE: home
 (home, irrigation, municipal, industrial)

WELL COMPLETION DATA:

- (1) diameter (inches) 2"
- (2) total depth (feet) 120'
- (3) static water level (feet) 70' below top of ground.
- (4) casing (material) galv. (depth) 117'
- (size) 2" if telescope see back.
- (5) screen (length) 3' (depth to top) 117'
- (size) 3/8" (material)
- (6) pump 1/4 (HP) 500 gal. h. (yield gpm)
- (type power) electric
- (7) electric log (yes or no)
- (organization running log)
- (8) how well bottom plugged B/D


LOGGED

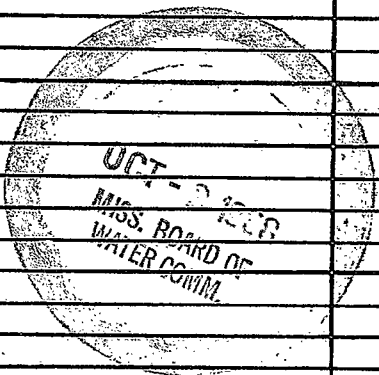

DRILLERS REMARKS:

If well telescopes please sketch and show depths.

GROUND LEVEL

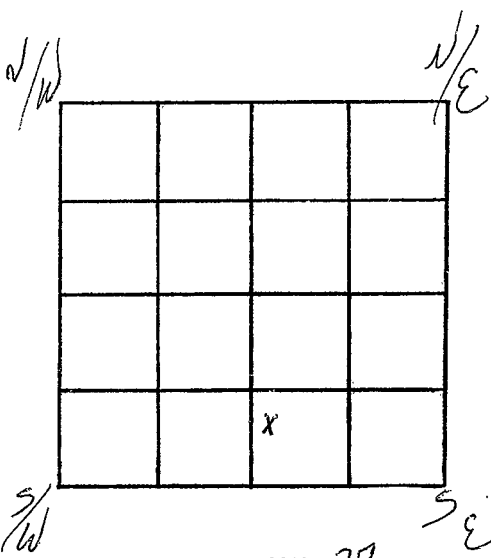

SECTION 27

Please indicate well location X.

ADDITIONAL INFORMATION

If more than one screen, show locations of each on sketch.