

CODED

MISSISSIPPI
BOARD OF WATER COMMISSIONERS
416 North State Street
Jackson, Mississippi 39201

SMITH
R 21
11- -69

WATER WELL DRILLERS LOG

Nov 69 Fraser Drilling Service Smith
date well completed firm name county well located

LANDOWNER: Town of
Taybesville
(mailing address)
WELL LOCATION:
sec. 20 T. 10N S R. 14W W
miles of (distance) (direction) (nearest town)

description of formations encountered	from	to
Top Soil	0	2
Clay	2	38
Sand	38	114
Clay	114	256
Clay w/ Sand Breaks	256	302
Sand	302	346
Clay	346	546
Fine Sand	546	558
Clay	558	562
Fine Sand	562	576
Clay	576	719

WELL PURPOSE: Municipal
(home, irrigation, municipal, industrial)

WELL COMPLETION DATA: Fraser Well
(1) diameter (inches) 12 3/4 x 8 5/8
(2) total depth (feet) 346'
(3) static water level (feet) 24 below top of ground. 21.35' above
(4) casing Steel, 300 (material) (depth), 12 3/4 (size) if telescope see back.
(5) screen 400 (length), 306' (depth to top), 8 5/8" (size), S.S. (material)
(6) pump 25 (HP), 500 (yield gpm), Electric (type power)
(7) electric log Yes (yes or no) # 160 U.S. F.S. (organization running log)
(8) how well bottom plugged BACK
WASH UP

NOV 24 1969


MISS. BD. OF
WATER COMM.

DRILLERS REMARKS:

2

If well telescopes please sketch and show depths.

GROUND LEVEL

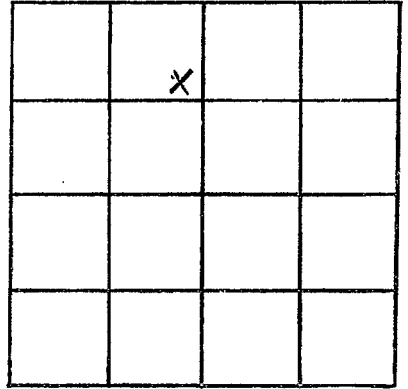

SECTION 20

Please indicate well location X.

ADDITIONAL INFORMATION

If more than one screen, show locations of each on sketch.