

CODED

Smith
R23
9-30-69

MISSISSIPPI
BOARD OF WATER COMMISSIONERS
416 North State Street
Jackson, Mississippi 39201

WATER WELL DRILLERS LOG

9-30 date well completed, 1969 W. K. Barnes Water wells Smith firm name, county well located

LANDOWNER: A. C. Perrigan
Taylorville Miss.
Rt 2
(mailing address)

description of formations encountered	from	to
Red clay	0	10
yellowed clay	10	48
1/2 in Sand	118	100
Water Course Sand	100	82

WELL LOCATION:
sec. 8 T. 10 N. R. 14 E
B3 miles north of Taylorville Miss.
(distance) (direction) (nearest town)

WELL PURPOSE: Home use
(home, irrigation, municipal, industrial)

WELL COMPLETION DATA:

(1) diameter (inches) 2

(2) total depth (feet) 82

(3) static water level (feet) 55 below above top of ground.

(4) casing Galv. (material) (depth) 1 1/4 if telescope see back. (size)

(5) screen 5' (length) (depth to top) 08 in. Stainless Steel (size) (material)

(6) pump 3 HP (yield gpm) 3 HP (type power) Elec.

(7) electric log no (yes or no)

(organization running log)

(8) how well bottom plugged Wash Valve


OCT 22 1969

MISS. BD. OF WATER COMMISSIONERS

DRILLERS REMARKS:

If well telescopes please sketch and show depths.

GROUND LEVEL

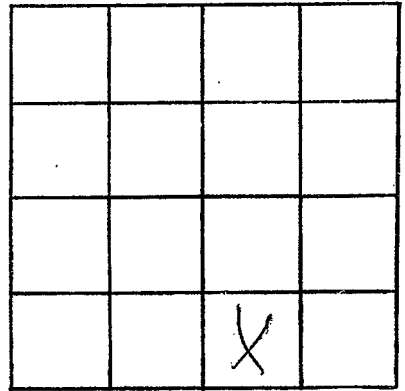

SECTION 8

Please indicate well location X.

ADDITIONAL INFORMATION

If more than one screen,
show locations of each on sketch.