

Smith
R 25
11-15-69

CODED

MISSISSIPPI
 BOARD OF WATER COMMISSIONERS
 416 North State Street
 Jackson, Mississippi 39201

WATER WELL DRILLERS LOG

11-15 1969 W.K. Barnes water well Smith
 date well completed firm name county well located

LANDOWNER: Burlon Thompson
Route 3
Jaykersville cross
 (mailing address)

description of formations encountered	from	to
<u>Red clay</u>	<u>0</u>	<u>8</u>
<u>yellow clay</u>	<u>8</u>	<u>23</u>
<u>fine sand</u>	<u>23</u>	<u>40</u>
<u>yellow clay</u>	<u>40</u>	<u>80</u>
<u>Rock</u>	<u>80</u>	<u>82</u>
<u>Course Red sand</u>	<u>82</u>	<u>110</u>

WELL LOCATION:
 sec. 15 T. 10 R. 14
S E
3 miles East of Jaykersville
 (distance) (direction) (nearest town)

WELL PURPOSE: Flange well
 (home, irrigation, municipal, industrial)

WELL COMPLETION DATA:
 (1) diameter (inches) 2
 (2) total depth (feet) 110
 (3) static water level (feet) 51 below above of ground.
 (4) casing Galv. 105
 (material) (depth)
2 if telescope see back.
 (size)
 (5) screen 4 ft
 (length) (depth to top)
8 Slot, Stainless Steel
 (size) (material)
 (6) pump 3/4 10
 (HP) (yield gpm)
6 Sec.
 (type power)
 (7) electric log no
 (yes or no)
 (organization running log)
 (8) how well bottom plugged Washed


IAN - 5 1970

MISS. DEPT. OF
 WATER CONTROL

DRILLERS REMARKS:

If well telescopes please sketch and show depths.

GROUND LEVEL

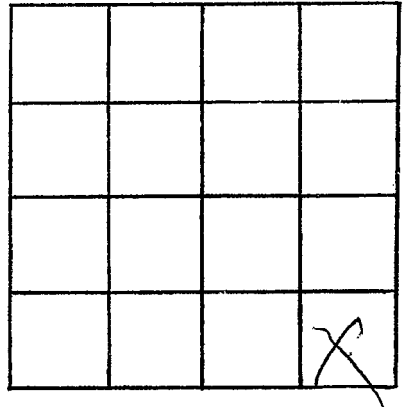

SECTION 15

Please indicate well location X.

ADDITIONAL INFORMATION

If more than one screen,
show locations of each on sketch.