

Smith Co
 R27
 12-17-69

MISSISSIPPI
 BOARD OF WATER COMMISSIONERS
 416 North State Street
 Jackson, Mississippi 39201

CODED

WATER WELL DRILLERS LOG

12-17 1969 WK. BARNES Water Wells Smith
 date well completed firm name county well located

LANDOWNER: Gale Nicksanath
 Route 2
 Taylorsville, Miss
 (mailing address)

description of formations encountered	from	to
Red CLAY	0	6
yellow CLAY	6	20
Water SAND	20	61

WELL LOCATION:
 sec 25 T. 10 N R. 14 E
 1.5 miles S of Taylorsville
 (distance) (direction) (nearest town)

WELL PURPOSE: Home Use
 (home, irrigation, municipal, industrial)

- WELL COMPLETION DATA:
- (1) diameter (inches) 2
 - (2) total depth (feet) ~~57~~ 61
 - (3) static water level (feet) 40 below top of ground.
 - (4) casing GALV 57 (material) (depth)
 2 (size) if telescope see back.
 - (5) screen 4 (length) (depth to top)
 2 in STAINLESS STEEL (size) (material)
 - (6) pump 3/4 (HP) 10 (yield gpm)
 Elect (type power)
 - (7) electric log NO (yes or no)
 - (8) how well bottom plugged WASH VALE


JAN - 5 1970

MISS. Bd. OF WATER COMMISSIONERS

DRILLERS REMARKS:

If well telescopes please sketch and show depths.

GROUND LEVEL

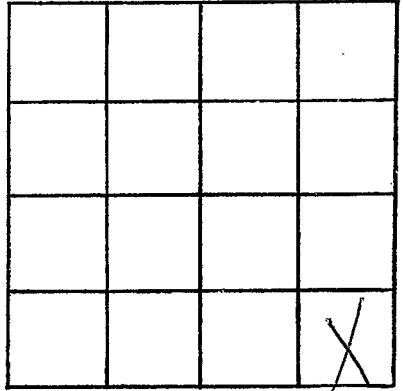

SECTION 25

Please indicate well location X.

ADDITIONAL INFORMATION

If more than one screen, show locations of each on sketch.