

CODED
CODED

MISSISSIPPI
BOARD OF WATER COMMISSIONERS
416 North State Street
Jackson, Mississippi 39201

WATER WELL DRILLERS LOG

Hershell Taylor Water

SMITH
R 28
11-11-69

11-11 1969
date well completed

Route One Phone
firm name
Ellisville, Miss. 37401

Smith
county well located

LANDOWNER: Cletha Brown

description of formations encountered

from to

RT

gray chalk

0 90

Jaylows
(mailing address)

spotted sand

90 105

WELL LOCATION:

sec. 19 T. 10 N. R. 13 E
5 miles E of Jaylows
(distance) (direction) (nearest town)

fine sand & chalk

90 115

WELL PURPOSE: home
(home, irrigation, municipal, industrial)

course sand

115 136

WELL COMPLETION DATA:

(1) diameter (inches) 2"

(2) total depth (feet) 136'

(3) static water level (feet) 61 below above top of ground.

(4) casing plastic 133
(material) (depth)

(size) If telescope see back.

(5) screen 3' 133
(length) (depth to top)

1 1/2" galv
(size) (material)

(6) pump _____
(HP) (yield gpm)

(type power)

(7) electric log _____
(yes or no)

(organization running log)

(8) how well bottom plugged 1/2


DRILLERS REMARKS:

JAN 23 1970

MISS. BD. OF
WATER COMMISSIONERS

If well telescopes please sketch and show depths.

GROUND LEVEL

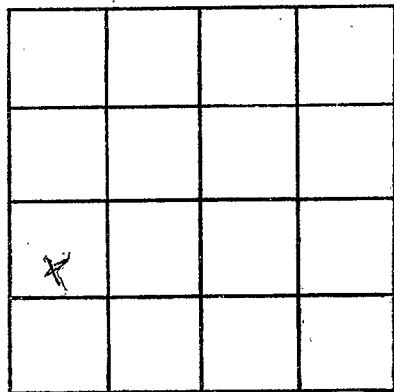

SECTION 19

Please indicate well location X.

ADDITIONAL INFORMATION

If more than one screen, show locations of each on sketch.