

Smith
R29
1-31-70

MISSISSIPPI
BOARD OF WATER COMMISSIONERS
416 North State Street
Jackson, Mississippi 39201

CODED

WATER WELL DRILLERS LOG

1-31 date well completed 1970 W.K. Barnes Water Wells Smith firm name Washville county well located

LANDOWNER: Key Baker
Route 2
Bay Springs Miss.
(mailing address)

description of formations encountered	from	to
<u>red clay</u>	<u>0</u>	<u>8</u>
<u>red sand</u>	<u>8</u>	<u>30</u>
<u>yellow clay</u>	<u>30</u>	<u>46</u>
<u>Fine Sand + Clay mixed</u>	<u>46</u>	<u>75</u>
<u>Fine Sand</u>	<u>75</u>	<u>96</u>
<u>Coarse Sand</u>	<u>96</u>	<u>121</u>

WELL LOCATION:
sec. 10 T. 10 N. R. 13 E. S. 5
8 miles South of Bay Springs
(distance) (direction) (nearest town)

WELL PURPOSE: Flow
(home, irrigation, municipal, industrial)

WELL COMPLETION DATA:
(1) diameter (inches) 2
(2) total depth (feet) 121
(3) static water level (feet) 104 below above top of ground.
(4) casing Galv. (material) (depth)
8 Slot if telescope see back. (size)
(5) screen 4 (length) (depth to top)
2" (size) Stainless Steel (material)
(6) pump 1 1/2 (HP) 10 (yield gpm)
Elec. (type power)
(7) electric log no (yes or no)
(organization running log)
(8) how well bottom plugged Washville

CODED


MAR 20 1970

Miss. Bd. of
Water Comm.

DRILLERS REMARKS:

If well telescopes please sketch and show depths.

GROUND LEVEL

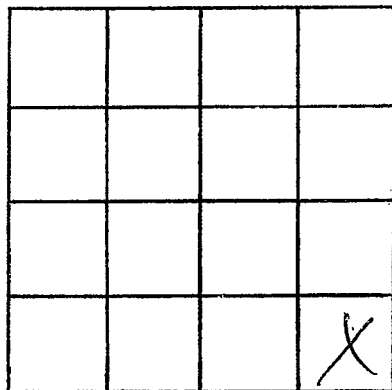

SECTION 6

Please indicate well location X.

ADDITIONAL INFORMATION

If more than one screen,
show locations of each on sketch.