

CODED

Smith  
R 30  
2-6-70

MISSISSIPPI  
BOARD OF WATER COMMISSIONERS  
416 North State Street  
Jackson, Mississippi 39201

WATER WELL DRILLERS LOG

2-6 date well completed      70 W.K. Barnes Water Wells Smith firm name      county well located

LANDOWNER: Quella Dickson Smith  
Route 3  
Jay Lovell miss  
(mailing address)

description of formations encountered	from	to
Red Clay	0	6
yellow Hard	6	22
Fine Sand	22	35
yellow clay	35	44
Fine Sand	44	72
Course Sand	72	84

WELL LOCATION:  
sec. 1 T. 10 S. R. 13 E. W  
4 miles East of Taylorsville  
(distance) (direction) (nearest town)

WELL PURPOSE: Home  
(home, irrigation, municipal, industrial)

WELL COMPLETION DATA:

(1) diameter (inches) 2

(2) total depth (feet) 84

(3) static water level (feet) 52 below above top of ground.

(4) casing Galv. (material) (depth) \_\_\_\_\_  
2" if telescope see back. (size)

(5) screen 4' (length) (depth to top) \_\_\_\_\_  
8 slot stainless S (size) (material)

(6) pump 3/4 (HP) 8 (yield gpm)  
elec (type power)

(7) electric log no (yes or no)  
(organization running log) \_\_\_\_\_

(8) how well bottom plugged Washed

MAR 20 1970


MISS. BD. OF  
WATER COMM.

DRILLERS REMARKS:

CODED

If well telescopes please sketch and show depths.

GROUND LEVEL

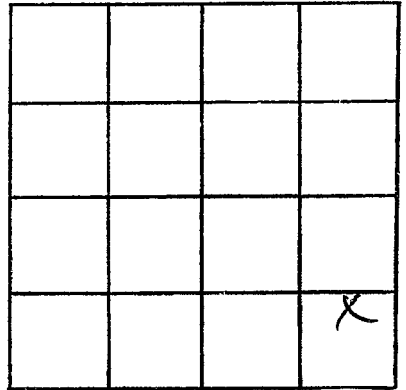

SECTION 1

Please indicate well location X.

ADDITIONAL INFORMATION

If more than one screen,  
show locations of each on sketch.