

Smith.
R 31
3-18-70

MISSISSIPPI
BOARD OF WATER COMMISSIONERS
416 North State Street
Jackson, Mississippi 39201

INDEXED

WATER WELL DRILLERS LOG

3-18 date well completed 1970 W.K. Barnes Water Wells Smith firm name county well located

LANDOWNER: Charles Craft
Taylorville Miss.
(mailing address)

WELL LOCATION:
sec. 8 T. 10 (N) R. 14 (E)
S (W)
2 miles North of Taylorville
(distance) (direction) (nearest town)

WELL PURPOSE: Cat from Pond
(home, irrigation, municipal, industrial)

WELL COMPLETION DATA:
(1) diameter (inches) 4"
(2) total depth (feet) 450'
(3) static water level (feet) 53 below top of ground.
2x 4" casing 4" (material) 2" 189' (depth)
2x4" (size) if telescope see back.
(5) screen 24' (length) (depth to top)
18 slot stainless steel (size) (material)
(6) pump 5 Sub (HP) 120 (yield gpm)
Blue (type power)
(7) electric log no (yes or no)
(organization running log)
(8) how well bottom plugged Lead Packer 2x4"


| description of formations encountered | from | to |
|---------------------------------------|------|-----|
| Red Clay | 0 | 8 |
| yellow clay | 8 | 14 |
| Hard yellow clay | 14 | 32 |
| Fine sand | 32 | 46 |
| Course sand | 46 | 52 |
| yellow clay | 52 | 65 |
| Course sand | 65 | 78 |
| ROCK | 78 | 81 |
| Blue clay | 81 | 190 |
| ROCK | 190 | 196 |
| Blue clay | 196 | 220 |
| Fine sand | 220 | 240 |
| Blue clay | 240 | 255 |
| Fine sand | 255 | 280 |
| Blue clay | 280 | 296 |
| Rock | 296 | 310 |
| Blue clay | 310 | 340 |
| Rock Hard | 340 | 360 |
| Blue clay | 360 | 380 |
| Fine sand | 380 | 396 |
| Blue clay | 396 | 420 |
| Course sand | 420 | 450 |

MAR 20 1970
MISS. BD. OF WATER COMMISSIONERS

DRILLERS REMARKS:

If well telescopes please sketch and show depths.

GROUND LEVEL

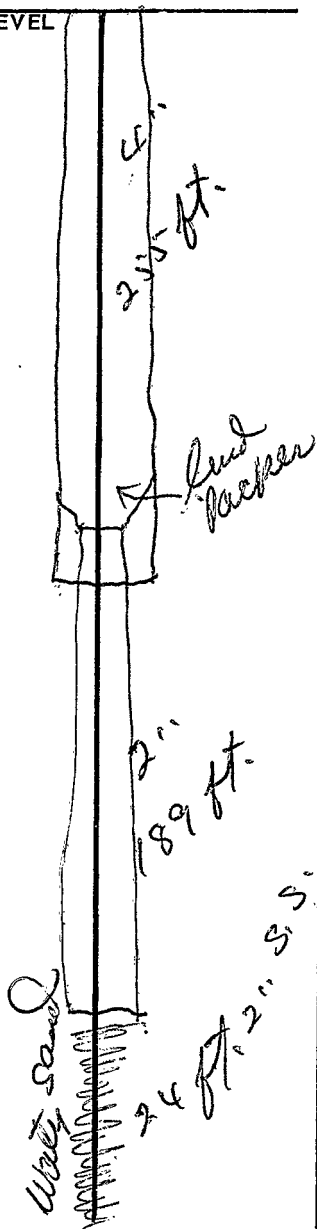

| | | | |
|--|--|---|--|
| | | | |
| | | | |
| | | | |
| | | X | |

SECTION 8

Please indicate well location X.

ADDITIONAL INFORMATION

If more than one screen, show locations of each on sketch.