

SMITH
R 34
6-30-70

MISSISSIPPI
BOARD OF WATER COMMISSIONERS
416 North State Street
Jackson, Mississippi 39201

CODED

WATER WELL DRILLERS LOG

6-30 1970 W.K. Barnes Water Wells Smith
date well completed firm name county well located

LANDOWNER:	description of formations encountered	from	to
Millard Wilmer Route 3	Red Clay	0	8
Taylorville Miss. (mailing address)	yellow clay dark sand	8	36
		36	62

WELL LOCATION:

sec. 25 T 10 N R 14 E
S W
2 miles north of SUMMER LAND
(distance) (direction) (nearest town)

CODED

WELL PURPOSE: HOME USE
(home, irrigation, municipal, industrial)

WELL COMPLETION DATA:

- (1) diameter (inches) 2
- (2) total depth (feet) 62
- (3) static water level (feet) 38 below top of ground.
- (4) casing Galv. 58 (material) (depth)
- 2" (size) if telescope see back.
- (5) screen 4' (length) (depth to top)
- 07, Stainless Steel (size) (material)
- (6) pump 3/4 (HP) 10 (yield gpm)
- Plc (type power)
- (7) electric log No (yes or no)

(organization running log)


(8) how well bottom plugged Wash well

DRILLERS REMARKS:

SEP 9 1970

If well telescopes please sketch and show depths.

GROUND LEVEL

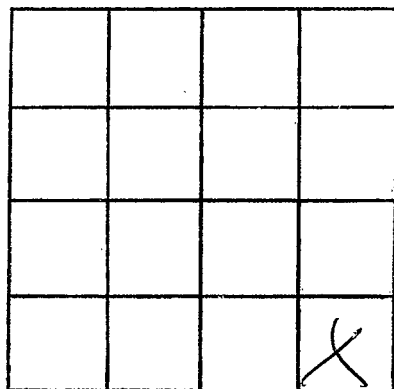

SECTION 25

Please indicate well location X.

ADDITIONAL INFORMATION

If more than one screen,
show locations of each on sketch.