

Smith  
R35  
7-69

MISSISSIPPI  
BOARD OF WATER COMMISSIONERS  
416 North State Street  
Jackson, Mississippi 39201

**CODED**

WATER WELL DRILLERS LOG

7-5 date well completed      1969 W.K. Barnes water wells firm name      Smith county well located

LANDOWNER: Annie Mae Page

description of formations encountered

from to

Route 3

Red

0 5

Jaylorsville miss.  
(mailing address)

yellow clay

5 41

fine sand

41 52

yellow clay

52 91

Blue clay

91 110

Course Sand

110 136

WELL LOCATION:

sec. 24 T 10 N R. 14 E

2 miles north of Summerland  
(distance) (direction) (nearest town)

WELL PURPOSE: Home  
(home, irrigation, municipal, industrial)

WELL COMPLETION DATA:

**CODED**

(1) diameter (inches) 2

(2) total depth (feet) 136

(3) static water level (feet) 58 below above top of ground.

(4) casing Plastic, 132  
(material) (depth)

         if telescope see back.  
(size)

(5) screen 4 (length) (depth to top)

8 slot, Stainless Steel  
(size) (material)

(6) pump 3/4 (HP) 7 (yield gpm)

Elec  
(type power)

(7) electric log no  
(yes or no)

          
(organization running log)

(8) how well bottom plugged wash valve


AUG 4 1969

MISS. BD. OF WATER COMM.

DRILLERS REMARKS:

If well telescopes please sketch and show depths.

GROUND LEVEL

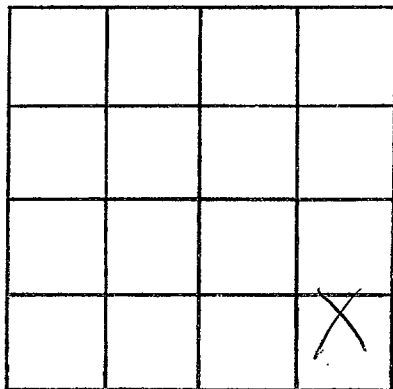

SECTION 24

Please indicate well location X.

ADDITIONAL INFORMATION

If more than one screen,  
show locations of each on sketch.