

Smith  
R 36  
7-69

MISSISSIPPI  
BOARD OF WATER COMMISSIONERS  
416 North State Street  
Jackson, Mississippi 39201

**CODED**

**WATER WELL DRILLERS LOG**

7-23 date well completed      1969 W.K. Barnes Water Wellers firm name      Smith county well located

LANDOWNER: S. M. Stephens  
Route 3  
Taylorville Miss.  
(mailing address)

description of formations encountered	from	to
Red Clay	0	10
Red Sand	10	30
yellow sand & clay mix	30	55
Fine Sand	55	74
yellow clay	74	89
Fine sand	89	110
Course & Sand & gravel	110	130

WELL LOCATION:  
sec. 17 T. 10 N. R. 13 E  
S      E  
5 miles North of Summerland  
(distance) (direction) (nearest town)

WELL PURPOSE: Home  
(home, irrigation, municipal, industrial)

WELL COMPLETION DATA:

(1) diameter (inches) 2

(2) total depth (feet) 130

(3) static water level (feet) 50 below above top of ground.

(4) casing Plastic, 126,  
(material) (depth)  
2" if telescope see back.  
(size)

(5) screen 4',  
(length) (depth to top)  
8 slot, Stainless Steel  
(size) (material)

(6) pump 1-H.P. 10  
(HP) (yield gpm)  
Blw  
(type power)

(7) electric log no  
(yes or no)

(organization running log)

(8) how well bottom plugged wash down

**CODED**


APR 4 1969

MISS. Bd. OF WATER COMM.  
4122-0-2378

DRILLERS REMARKS:

If well telescopes please sketch and show depths.

GROUND LEVEL

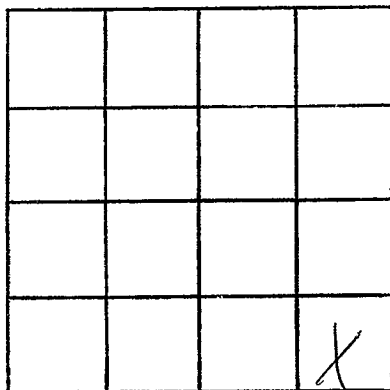

SECTION 17

Please indicate well location X.

ADDITIONAL INFORMATION

If more than one screen,  
show locations of each on sketch.