

SMITH
R 37
9-15-70

MISSISSIPPI
BOARD OF WATER COMMISSIONERS
416 North State Street
Jackson, Mississippi 39201

CODED

WATER WELL DRILLERS LOG

CODED
Smith

9/15/70 19 J.R. Barber water d firm name Smith county well located

LANDOWNER: Sam Hayes description of formations encountered from to
RT 2
Taylorville Chalk 0 21
(mailing address) water sand 21 64

WELL LOCATION:
sec. 26 T. 100 N. R. 14 E. S. 10
_____ miles _____ of _____
(distance) (direction) (nearest town)

WELL PURPOSE: Normal
(home, irrigation, municipal, industrial)

WELL COMPLETION DATA:
(1) diameter (inches) 4
(2) total depth (feet) 64
(3) static water level (feet) 30 below above top of ground.
(4) casing plast. 6.0
(material) (depth)
_____ if telescope see back.
(size)
(5) screen 4 ft 14
(length) (depth to top)
2 in 5
(size) (material)
(6) pump 2 5
(HP) (yield gpm)
Jet
(type power)
(7) electric log _____
(yes or no)

(organization running log)
(8) how well bottom plugged sand


CODED

SEP 21 1970

DRILLERS REMARKS:

If well telescopes please sketch and show depths.

GROUND LEVEL

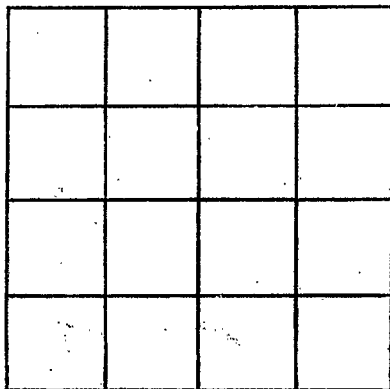

T101

R14W

SECTION 26

Please indicate well location X.

ADDITIONAL INFORMATION

200 ft. borehole
70 ft. radius east
off highway 28

If more than one screen, show locations of each on sketch.