

SMITH
R 38

MISSISSIPPI
BOARD OF WATER COMMISSIONERS
416 North State Street
Jackson, Mississippi 39201

CODED

WATER WELL DRILLERS LOG

J.P. Park - natural field
Smith

date well completed 19

firm name

county well located

LANDOWNER: *Rod Ogden*

description of formations encountered

from

to

chicks

0 20

20-30

20 30

Chalk

30 90

water band

90 115

(mailing address)

WELL LOCATION:

sec. *9* T. *10* S. R. *13* E. *W*

miles of (distance) (direction) (nearest town)

WELL PURPOSE:
(home, irrigation, municipal, industrial)

WELL COMPLETION DATA:

CODED

- (1) diameter (inches) *4*
- (2) total depth (feet) *115*
- (3) static water level (feet) *40* ^{below} above top of ground.
- (4) casing *Plastic 1 1/2*
(material) (depth)

if telescope see back.
(size)

- (5) screen *4 FT 1 1/2*
(length) (depth, to top)

2 in. 2
(size) (material)

- (6) pump *1/2* *1 1/2*
(HP) (yield gpm)

2 1/2
(type power)

- (7) electric log (yes or no)

(organization running log)

- (8) how well bottom plugged *chick*


DRILLERS REMARKS:

SEP 21 1970

MISS. BD OF
WATER COMMISSIONERS

If well telescopes please sketch and show depths.

GROUND LEVEL

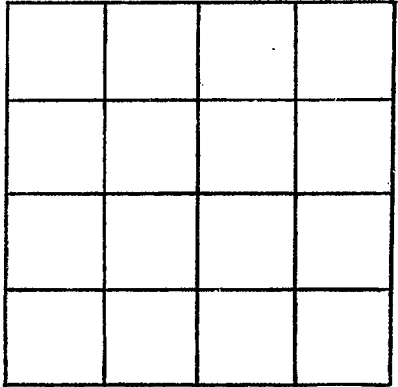

TOP

R 134 SECTION *Q*

Please indicate well location X.

ADDITIONAL INFORMATION

See also...
...
...
...

If more than one screen, show locations of each on sketch.