

SMITH  
R 41  
7-19-71

MISSISSIPPI  
BOARD OF WATER COMMISSIONERS  
416 North State Street  
Jackson, Mississippi 39201

**CODED**

WATER WELL DRILLERS LOG

July 19 1971 J.R. Barber Water Well Drilling Smith  
date well completed firm name county well located

LANDOWNER: J.R. Barber  
RT-1  
Taylorsville Miss.  
(mailing address)

description of formations encountered	from	to
chalk	0	30
corde hard	30	50

WELL LOCATION:  
sec. 7 T-10 N R-14 E  
1 1/2 miles west of Taylorsville on 37 Highway  
(distance) (direction) (nearest town)

WELL PURPOSE: NONE  
(home, irrigation, municipal, industrial)

- WELL COMPLETION DATA:
- (1) diameter (inches) 2
  - (2) total depth (feet) 50
  - (3) static water level (feet) 30 below top of ground
  - (4) casing PVC, 4.5 (depth)
  - (size) if telescope see back.
  - (5) screen 5 ft 50 ft (length) (depth to top)
  - 2" PVC (size) (material)
  - (6) pump 1/2 (HP) 7 (yield gpm)
  - jet elec (type power)
  - (7) electric log (yes or no)
  - (organization running log)
  - (8) how well bottom plugged chalk

**CODED**


JUL 22 1971

MISS. BD. OF  
WATER COMM.

DRILLERS REMARKS:

If well telescopes please sketch and show depths.

GROUND LEVEL

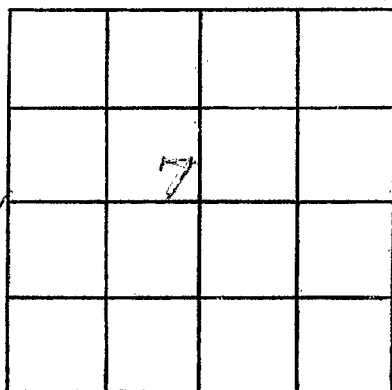

R14W

SECTION 7

Please indicate well location X.

ADDITIONAL INFORMATION

If more than one screen, show locations of each on sketch.