

SMITH  
R42  
3-21-71

MISSISSIPPI  
BOARD OF WATER COMMISSIONERS  
416 North State Street  
Jackson, Mississippi 39201

**CODED**

WATER WELL DRILLERS LOG

3-21-71 date well completed 1971 W.H. Barnes water well Smith firm name county well located

LANDOWNER: J. D. Pickering  
Route 2  
Taylorsville, Miss.  
(mailing address)

description of formations encountered	from	to
yellow clay	0	8
yellow chalk	8	28
yellow fine sand	28	41
yellow clay	41	59
yellow fine sand	59	65
yellow coarse sand	65	73

WELL LOCATION:  
sec. 30 T. 10 N. R. 14 E. S. 5 W.  
3 miles West of Taylorsville  
(distance) (direction) (nearest town)

WELL PURPOSE: Home  
(home, irrigation, municipal, industrial)


- WELL COMPLETION DATA:
- (1) diameter (inches) 2
  - (2) total depth (feet) 73
  - (3) static water level (feet) 23 below top of ground.
  - (4) casing Galv. 69 (material) (depth)  
2" if telescope see back. (size)
  - (5) screen 4 (length) (depth to top)  
0.8 Slot, Stainless S. (size) (material)
  - (6) pump 3/4 (HP) 10 (yield gpm)  
Elec. (type power)
  - (7) electric log NO. (yes or no)
  - (organization running log)
  - (8) how well bottom plugged Wash water

**CODED**

DRILLERS REMARKS:  
1971  
MISS. BD. OF WATER COMMISSIONERS

If well telescopes please sketch and show depths.

GROUND LEVEL

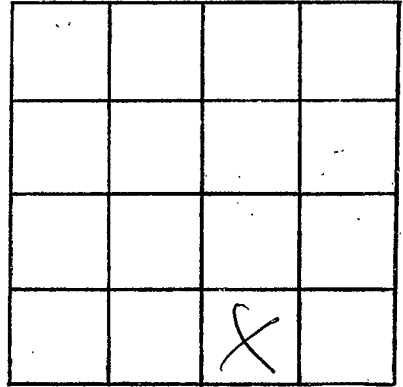

SECTION 30

Please indicate well location X.

ADDITIONAL INFORMATION

If more than one screen,  
show locations of each on sketch.