

SMITH
R-43
8-28-71

MISSISSIPPI
BOARD OF WATER COMMISSIONERS
416 North State Street
Jackson, Mississippi 39201

CODED

WATER WELL DRILLERS LOG

Aug 28 1971 G.L. Solar Water Well Drilling Smith
date well completed firm name county well located

LANDOWNER: <u>Emmanuel Gene Garrison</u>	description of formations encountered	from	to
<u>Taylorville</u>			
(mailing address)	<u>Service Sand</u>	<u>0</u>	<u>140</u>
	<u>gray chalk</u>	<u>140</u>	<u>160</u>
	<u>white chalk</u>	<u>160</u>	<u>180</u>
	<u>Sand</u>	<u>180</u>	<u>125</u>

WELL LOCATION:
sec. 20-T-100 R. 14-E
1/2 miles SOUTH of Taylorville
(distance) (direction) (nearest town)

WELL PURPOSE: HOME
(home, irrigation, municipal, industrial)

- WELL COMPLETION DATA:
- (1) diameter (inches) 2
 - (2) total depth (feet) 125
 - (3) static water level (feet) 140 below above top of ground.
 - (4) casing PVC 120
(material) (depth)
 - If telescope see back.
(size)
 - (5) screen 5ft 125ft
(length) (depth to top)
 - 2" PVC
(size) (material)
 - (6) pump 3/4 6
(HP) (yield gpm)
 - Get Elec
(type power)
 - (7) electric log
(yes or no)
 - (organization running log)
 - (8) how well bottom plugged chalk


SEP 1 1971

MISS. BD. OF
WATER COMM.

DRILLERS REMARKS:

If well telescopes please sketch and show depths.

GROUND LEVEL

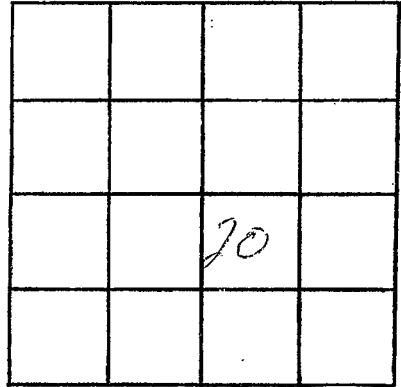

R14 W

SECTION 20

Please indicate well location X.

ADDITIONAL INFORMATION

*Go to the well of
State Dept. of
37 1/2 mile 2 hours
on west side of
line*

If more than one screen, show locations of each on sketch.