

SMITH
R-44
8-31-71

MISSISSIPPI
BOARD OF WATER COMMISSIONERS
416 North State Street
Jackson, Mississippi 39201

CODED

WATER WELL DRILLERS LOG

Aug 31 1971 J. R. Park Water Well Drillers Smith
date well completed firm name county well located

LANDOWNER: Donald Dombell
Taylorville, Miss.
(mailing address)

description of formations encountered	from	to
Chalk	0	40
fine sand	40	60
chalk	60	130
coarse sand	130	155

WELL LOCATION:
sec. 27 T 16 N R 1 E
3 miles west of Sumner
(distance) (direction) (nearest town)

WELL PURPOSE: Home
(home, irrigation, municipal, industrial)


- WELL COMPLETION DATA:
- (1) diameter (inches) 4
 - (2) total depth (feet) 155
 - (3) static water level (feet) 50 below top of ground
 - (4) casing galv. 149 (material) (depth)
 - 2 (size) if telescope see back.
 - (5) screen 6 155 (length) (depth to top)
 - 2 5/8 (size) (material)
 - (6) pump 1 1/2 15 (HP) (yield gpm)
 - sumb-Elco (type power)
 - (7) electric log (yes or no)
 - (organization running log)
 - (8) how well bottom plugged chalk

SEP 1 1971
MISS. BD. OF
WATER COMM.


DRILLERS REMARKS:

If well telescopes please sketch and show depths.

GROUND LEVEL

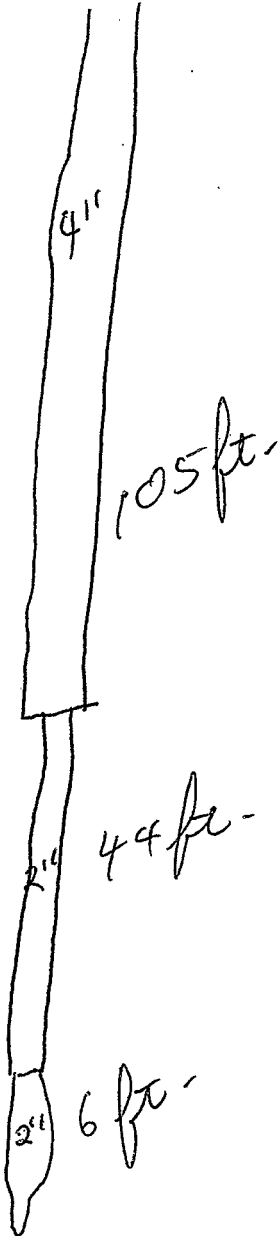

If more than one screen, show locations of each on sketch.

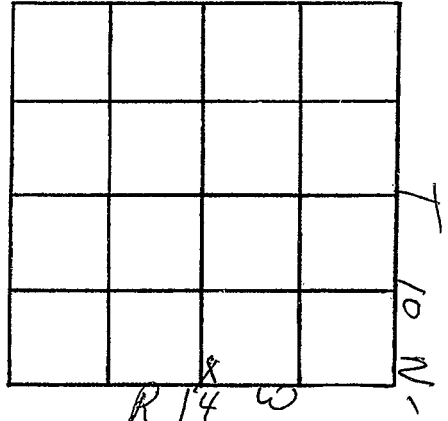

SECTION 27

Please indicate well location X.

ADDITIONAL INFORMATION

Turn off
Highway 28
to the right on
Dambell loop
3/4 mile on the
left.