

MISSISSIPPI  
BOARD OF WATER COMMISSIONERS  
416 North State Street  
Jackson, Mississippi 39201

**CODED**

WATER WELL DRILLERS LOG

SMITH  
R-45  
9-16-71

9/16 1971 date well completed  
G.R. Parker water well drs. firm name  
Smith county well located

LANDOWNER: Jimmy Magee  
RT. 3  
Tylorsville Miss  
(mailing address)

description of formations encountered	from	to
clay	0	20
white chalk	20	45
gray chalk	45	60
Carroll sand	60	80

WELL LOCATION:  
sec. 19 T 10 N R 13 E  
S  
5 miles East of Tylorsville  
(distance) (direction) (nearest town)

WELL PURPOSE: HOME  
(home, irrigation, municipal, industrial)

- WELL COMPLETION DATA:
- (1) diameter (inches) 2
  - (2) total depth (feet) 80
  - (3) static water level (feet) 40 <sup>below</sup> above top of ground.
  - (4) casing PVC, 75 ft (material) (depth)  
(size) If telescope see back.
  - (5) screen 5 ft, 80 ft (length) (depth to top)  
2" (size) PVC (material)
  - (6) pump 1/2 (HP) 17 (yield gpm)  
Jet Eject (type power)
  - (7) electric log (yes or no)
  - (organization running log)
  - (8) how well bottom plugged Chalk

**CODED**


SEP 22 1971

MISS. BD. OF  
WATER COMMISSIONERS

DRILLERS REMARKS:

If well telescopes please sketch and show depths.

GROUND LEVEL

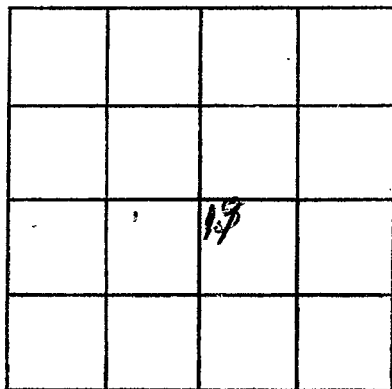

T10N

R. 13 W

SECTION 17

Please indicate well location X.

ADDITIONAL INFORMATION

Go East from Taylorville  
to Summers Gap take  
left go 1 mile take  
left to house on  
Right

If more than one screen,  
show locations of each on sketch.