

SMITH
R47
11-16-71

MISSISSIPPI
BOARD OF WATER COMMISSIONERS
416 North State Street
Jackson, Mississippi 39201

NOV 17 1971
CODED

WATER WELL DRILLERS LOG

11/16 1971 date well completed
J.R. Parker firm name
Wm Brumley county well located

LANDOWNER: J.R. Parker
Rt. 2
Way Crossville
(mailing address)

WELL LOCATION:
sec. 25 T. 10 N. R. 14 E.
in Summerland
(distance) miles (direction) of (nearest town)

WELL PURPOSE: HOME
(home, irrigation, municipal, industrial)

- WELL COMPLETION DATA:
- (1) diameter (inches) 2
 - (2) total depth (feet) 80
 - (3) static water level (feet) 30 ^{below} top of ground.
 - (4) casing PVC, 75,
(material) (depth)
If telescope see back.
(size)
 - (5) screen 5' x 80
(length) (depth to top)
2" 9/5
(size) (material)
 - (6) pump 1/2 8
(HP) (yield gpm)
jet
(type power)
 - (7) electric log _____
(yes or no)
(organization running log)
 - (8) how well bottom plugged sand

description of formations encountered	from	to
chalk	0	30
Red sand	30	40
Coarse Red sand	40	60
white chalk	60	65
white sand	65	80


Drilled old well 30 ft deeper

CODED

DRILLERS REMARKS: Drilled old well deeper 30 ft. from Red sand to white coarse sand

If well telescopes please sketch and show depths.

GROUND LEVEL

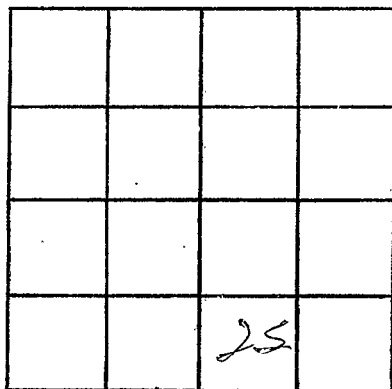

R14W

SECTION 25

Please indicate well location X.

ADDITIONAL INFORMATION

in Summerland

If more than one screen, show locations of each on sketch.