

SMITH
R48
11-15-71

MISSISSIPPI
BOARD OF WATER COMMISSIONERS
416 North State Street
Jackson, Mississippi 39201

NOV 18 1971

CODED

WATER WELL DRILLERS LOG

11/15 1971 J.R. Parker water well Dr. Smith
date well completed firm name county well located

LANDOWNER: W.J. Moffett
Rt 3
Taylorsville Miss
(mailing address)

description of formations encountered	from	to
Chalk	0	60
Red sand	60	90
Chalk	90	100
White sand	100	120

WELL LOCATION:
sec. 24 T 100 S R 11 E
1 miles South of Sumnerland
(distance) (direction) (nearest town)

WELL PURPOSE: Home
(home, irrigation, municipal, industrial)


- WELL COMPLETION DATA:
- (1) diameter (inches) 2
 - (2) total depth (feet) 120
 - (3) static water level (feet) 50 below top of ground.
 - (4) casing PVC, 115 (material) (depth)
 - (size) if telescope see back.
 - (5) screen 5 ft, 120 (length) (depth to top)
 - 2" PVC (size) (material)
 - (6) pump 3/4 HP, 5 gal (HP) (yield gpm)
 - jet (type power)
 - (7) electric log (yes or no)
 - (organization running log)
 - (8) how well bottom plugged chalk

CODED

DRILLERS REMARKS:

If well telescopes please sketch and show depths.

GROUND LEVEL

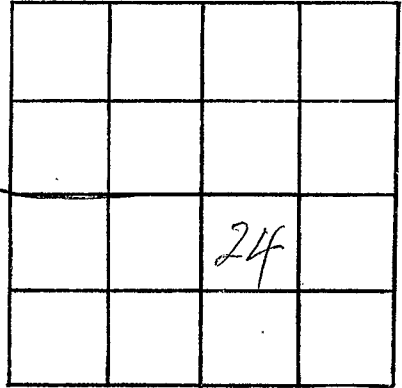

R14 W

SECTION 24

Please indicate well location X.

ADDITIONAL INFORMATION

*go to hammerhead
plate left go straight
2nd house on left*

If more than one screen,
show locations of each on sketch.