

SMITH
R 51
1-31-71

MISSISSIPPI
BOARD OF WATER COMMISSIONERS 9.4 1972
416 North State Street
Jackson, Mississippi 39201

WATER WELL DRILLERS LOG

1/31 1971 J.R. - Parker Water Well Drilling
Date well completed firm name Smith

CODED

LANDOWNER: Marell Moffett
RT 3
Taylorville Miss.
(mailing address)

description of formations encountered	COUNTED	
	from	to
Chalk	0	40
Yellow chalk	40	60
Rede Sand	60	72

WELL LOCATION:
sec. 19 T-10^N S R-13 E
1.5 miles South of Lumberton
(distance) (direction) (nearest town)

WELL PURPOSE: Home
(home, irrigation, municipal, industrial)


- WELL COMPLETION DATA:
- (1) diameter (inches) 2 1/2
 - (2) total depth (feet) 82
 - (3) static water level (feet) 30 below above top of ground.
 - (4) casing PVC 77
(material) (depth)
 - (size) if telescope see back.
 - (5) screen 5 ft. 82
(length) (depth to top)
 - 2"
(size) PVC
(material)
 - (6) pump 1/2 6
(HP) (yield gpm)
 - Jet
(type power)
 - (7) electric log (yes or no)
 - (organization running log)
 - (8) how well bottom plugged chalk

CODED

DRILLERS REMARKS:

If well telescopes please sketch and show depths.

GROUND LEVEL

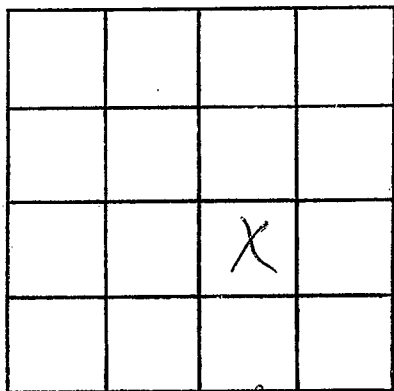

SECTION 19

Please indicate well location X.

ADDITIONAL INFORMATION

*90 to Summerland
Stops left 90 1/2
miles left left
3 hours on left*

If more than one screen,
show locations of each on sketch.