

SMITH
R53
3-28-72

MISSISSIPPI
BOARD OF WATER COMMISSIONERS **MAR 31 1972**
416 North State Street
Jackson, Mississippi 39201

WATER WELL DRILLERS LOG

CODED

3/28 1972 G.R. Parker Waterwell Smith
date well completed firm name county well located

LANDOWNER: John Hearn
RT 3
Taylorsville Miss
(mailing address)

description of formations encountered	from	to
Red clay	@	40
Coarse sand	40	110
Chalk	110	140
Water sand	140	160

WELL LOCATION:
sec. 11 T 10 N R 14 E S
1/4 miles east of Taylorsville
(distance) (direction) (nearest town)

WELL PURPOSE: Home
(home, irrigation, municipal, industrial)

- WELL COMPLETION DATA:
- (1) diameter (inches) 2
 - (2) total depth (feet) 160
 - (3) static water level (feet) 110 ^{below} above top of ground.
 - (4) casing P.V.C. 155 (material) (depth)
(size) if telescope see back.
 - (5) screen ~~5 ft~~ 160 (length) (depth to top)
2 in. P.V.C. (size) (material)
 - (6) pump 1 1/2 (HP) 4 (yield gpm)
Jet (type power)
 - (7) electric log (yes or no)
 - (organization running log)
 - (8) how well bottom plugged good
wash valve

CODED


MAR 31 1972

MISS. BD. OF
WATER COMM.

DRILLERS REMARKS:

If well telescopes please sketch and show depths.

GROUND LEVEL

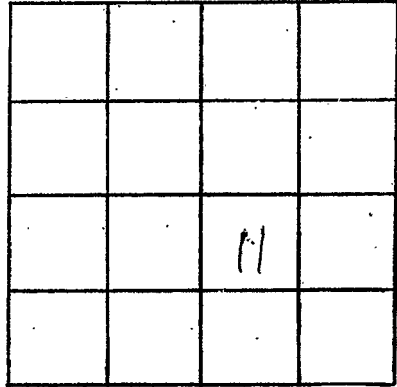

R 14 W

SECTION 11

Please indicate well location X.

ADDITIONAL INFORMATION

go to 531490 north
 off 28th to clear
 creek church turn off
 take right go 1/2 mi. take
 right go 1/2 mi. take left
 1st on left

If more than one screen, show locations of each on sketch.