

SMITH

~~SMITH~~

R54

3-16-72

MISSISSIPPI
BOARD OF WATER COMMISSIONERS
416 North State Street
Jackson, Mississippi 39201

CODED

Smith

WATER WELL DRILLERS LOG

Nov 16

1972 Royli West Water Wells

~~Smith~~

date well completed

firm name

county well located

LANDOWNER:

Ethelie Nuck with
Rt 3 Jayloville

description of formations encountered

Clay
Sandy clay
Sand

from

to

0 12
12 40
40 70

(mailing address)

WELL LOCATION:

sec. 31 T 10 N R 14 E

SW ~~31~~ miles N-E of Jayloville

(distance) miles (direction) of (nearest town)

WELL PURPOSE:

Home (home, irrigation, municipal, industrial)

WELL COMPLETION DATA:

- (1) diameter (inches) 2 in
- (2) total depth (feet) 70
- (3) static water level (feet) 35 below top of ground.
- (4) casing plastic, 65 (material) (depth)
- (size) If telescope see back.
- (5) screen 5 ft, 65 (length) (depth to top)
- 2 in plastic (size) (material)
- (6) pump 1/2 (HP) 8 (yield gpm)
- REA (type power)
- (7) electric log No (yes or no)

CODED

(organization running log)

(8) how well bottom plugged

Washed


MAY 2 1972

DRILLERS REMARKS:

MISS. BD. OF
WATER COM.

If well telescopes please sketch and show depths.

GROUND LEVEL

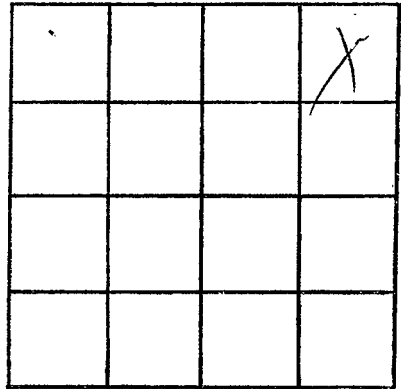

SECTION 30

Please indicate well location X.

ADDITIONAL INFORMATION

A series of horizontal lines for writing additional information.

If more than one screen, show locations of each on sketch.