

SMITH  
R 56  
5-22-73

MISSISSIPPI  
BOARD OF WATER COMMISSIONERS  
416 North State Street  
Jackson, Mississippi 39201

**CODED**

WATER WELL DRILLERS LOG

May 22 1973 Roy W. Smith at Waterwells Smith  
date well completed firm name county well located

LANDOWNER: <u>Condon Borne</u>	description of formations encountered	from	to
<u>Taylorville Rt 1</u>			
(mailing address)	<u>Red Clay</u>	<u>0</u>	<u>8</u>
	<u>Clay</u>	<u>8</u>	<u>105</u>
	<u>sandy clay</u>	<u>105</u>	<u>80</u>
	<u>Sand</u>	<u>80</u>	<u>119</u>

WELL LOCATION:  
sec. 30 T 10 N R 1 E  
3 miles S of Taylorville  
(distance) (direction) (nearest town)

WELL PURPOSE: Home  
(home, irrigation, municipal, industrial)

- WELL COMPLETION DATA:
- (1) diameter (inches) 2 in
  - (2) total depth (feet) 119
  - (3) static water level (feet) 55 below top of ground.
  - (4) casing galv 114  
(material) (depth)  
(size) if telescope see back.
  - (5) screen 5 114  
(length) (depth to top)  
1/4 S.T. Steel  
(size) (material)
  - (6) pump 1 8  
(HP) (yield gpm)  
R & A  
(type power)
  - (7) electric log NO  
(yes or no)
  - (8) how well bottom plugged crushed water


**CODED**

DRILLERS REMARKS: \_\_\_\_\_

JUN 15 1973

If well telescopes please sketch and show depths.

GROUND LEVEL

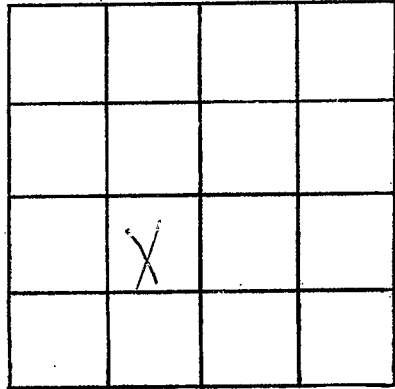

SECTION 30

Please indicate well location X.

ADDITIONAL INFORMATION

If more than one screen,  
show locations of each on sketch.