

Smith
R 57
2-5-75

C. P. CLARK
MISSISSIPPI WATER WELL DRILLING
BOARD OF WATER COMMISSIONERS
416 North State Street
Jackson, Mississippi 39201
LAUREL, MISS. 39440

WATER WELL DRILLERS LOG CODED

2/5 1975 C.P. Clark Smith
date well completed firm name county well located

LANDOWNER: Wes Blakney
Taylorville Miss
(mailing address)


description of formations encountered	from	to
<u>Yellow clay</u>	<u>0</u>	<u>17</u>
<u>sand</u>	<u>17</u>	<u>35</u>

WELL LOCATION:
sec. 29 T. 10 N. R. 1 E. 134
S. W.
1 miles South of Taylorville
(distance) (direction) (nearest town)

WELL PURPOSE: Home
(home, irrigation, municipal, industrial)

- WELL COMPLETION DATA:
- (1) diameter (inches) 2
 - (2) total depth (feet) 35
 - (3) static water level (feet) 14 below top of ground.
 - (4) casing Galv. draw 30
(material) (depth)
(size) if telescope see back.
 - (5) screen 5 30
(length) (depth to top)
1/4 Solid S.S.
(size) (material)
 - (6) pump 1/2 10
(HP) (yield gpm)
210V
(type power)
 - (7) electric log No
(yes or no)
 - (organization running log)
 - (8) how well bottom plugged BWV


DRILLERS REMARKS: Set
Customer Myers
Pump @ 210V

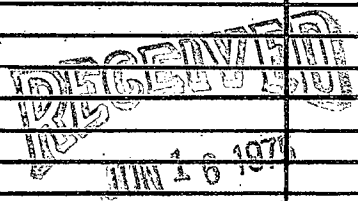

MISS. BD. OF WATER COMMISSIONERS

If well telescopes please sketch and show depths.

GROUND LEVEL

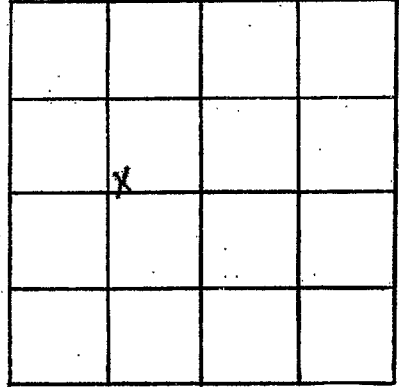

SECTION 29

Please indicate well location X.

ADDITIONAL INFORMATION

A series of horizontal lines for writing additional information.

If more than one screen, show locations of each on sketch.