

Smith
R 58
2-5-75

C. P. CLARK
WATER WELL DRILLING
ROUTE 2
MISSISSIPPI BOARD OF WATER COMMISSIONERS, MISS. 39440
416 North State Street
Jackson, Mississippi 39201

WATER WELL DRILLERS LOG CODED

2/5 1975 C.P. Clark Smith
date well completed firm name county well located

LANDOWNER: Ross Blakney
Taylorsville Miss

description of formations encountered	from to	
	feet	feet
Sandy Clay	0	7
Gravel	7	10
Course Sand	10	25

(mailing address)

WELL LOCATION:
sec. 29 T. 10 N. R. 15 E 1300
S
1 1/4 miles South of Taylorsville
(distance) (direction) (nearest town)

WELL PURPOSE: Barn
(home, irrigation, municipal, industrial)

CODED

WELL COMPLETION DATA:

- (1) diameter (inches) 2
- (2) total depth (feet) 26
- (3) static water level (feet) 7 1/2 below top of ground.
- (4) casing Galv. Iron 21 (material) (depth)
- (size) If telescope see back.
- (5) screen 5 21 (length) (depth to top)
- 1 1/4 Solid S.S. (size) (material)
- (6) pump 1/2 10 (HP) (yield gpm)
- 1100 (type power)
- (7) electric log No (yes or no)

(organization running log)

(8) how well bottom plugged Bwv


MISSISSIPPI
JUN 18 1975

DRILLERS REMARKS: Set 10 A
Get @ 18 ft near
1/2 H.P. F+W

MISS. BD. OF WATER COMMISSIONERS

If well telescopes please sketch and show depths.

GROUND LEVEL

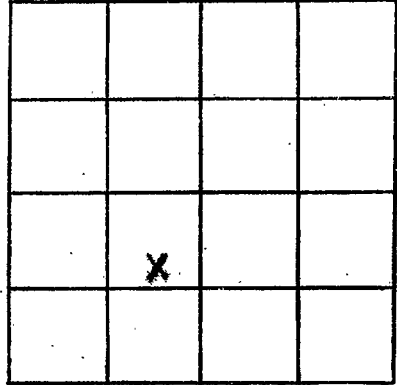

SECTION 29

Please indicate well location X.

ADDITIONAL INFORMATION

If more than one screen,
show locations of each on sketch.